

KANSAS

Russell


FORM 51 5M 4-41 PETROL

Section 13 Township 14 Range 15-W

Well No. #2 Milberger

Company Cities Service Oil

NORTH Gorham pool

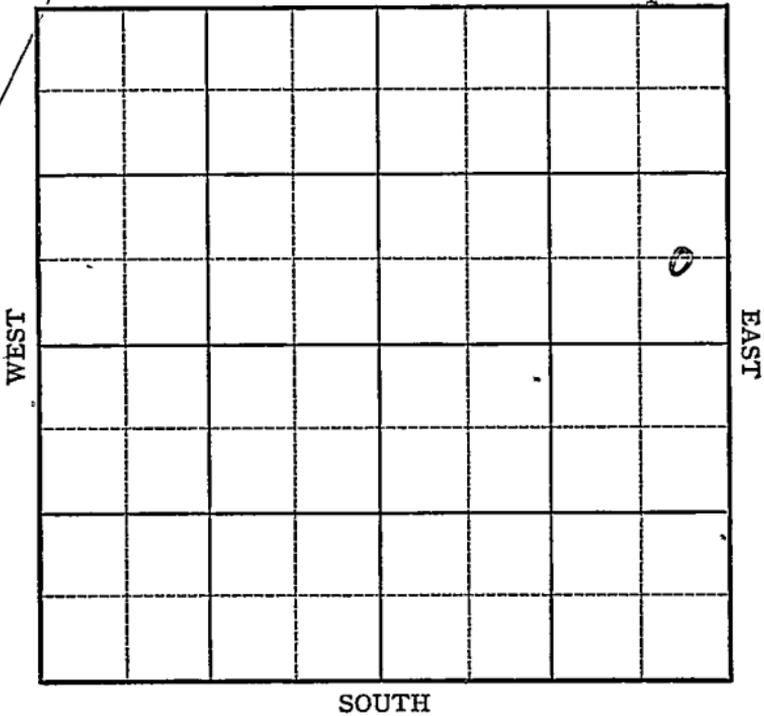

Sec. 13 Twp. 14 R. 15-W

Well No. #2 Milberger Farm

Cities Service Oil Company

(Gorham)


_____ Ft. from N. Line

660 Ft. from S. Line

330 Ft. from E. Line

_____ Ft. from W. Line

Elev. 1887

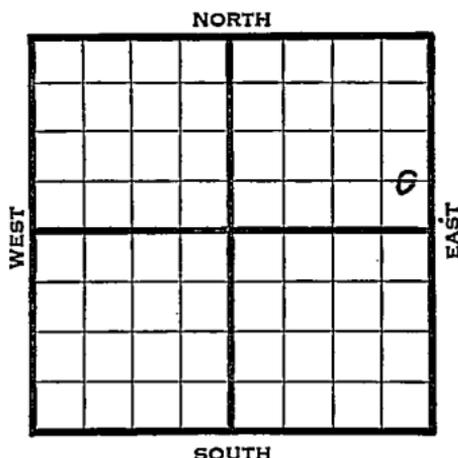

1942	REPORT
6/10	Location
6/17	8" - 357' Drlg. 685'
6/24	Tarkio 2482' Topeka 2715' Drlg. 2786'
7/1	Lans. 3071'
	B.K.C. 3308'
	Arb. 3323'
	T.D. 3353'
	No shows.
	ABANDONED

Russell

Map No. 72 Sec. 13 Twp. 14 R. 15WWell No. 2 MilbergerCities Service Oil Company**FIRST REPORT** Contractor

C E L S E N E

SECTION PLAT

_____ Ft. from N. Line

660 Ft. from S. Line330 Ft. from E. Line

_____ Ft. from W. Line

			0

GORHAM POOL

Location XX

Rig up _____

Drilling and Remarks:

RECORD

Cased _____ in., _____ ft.

Sand _____

Gas _____

Oil _____

Total Depth _____

PRODUCTION

1st 24 hrs. Nat. _____

1st 24 hrs. after shot _____

Gas 0.0 Cu. Ft.

Dry Hole _____

Abandoned _____

Date

JUN 1 0 1942

19

S. J. LEWIS

Scout

Russell

KANSAS

Map No. 72 Sec. 13 Twp. 14 R. 15W

Well No. 2 Milberger

Cities Service Oil Company

ABANDONED Contractor

C E L S E N E

SECTION PLAT

 Ft. from N. Line

660 Ft. from S. Line

330 Ft. from E. Line

 Ft. from W. Line

GORHAM POOL

RECORD

Location

Cased in., ft.

Rig up

Sand

Drilling and Remarks:

Gas

Liams 3071

Oil

BKC 3305

Total Depth 3357

Cr 3323

No shows

PRODUCTION

1st 24 hrs. Nat.

1st 24 hrs. after shot

Gas Cu. Ft.

Dry Hole

Abandoned

Date

JUL 1 1942 19

S. J. LEWIS Scout