

FORM 57-25M 8-50 WESTERN

Russell KANSAS

Section 13 Township 14 Range 15W

Well No. #3 Milberger

<u>Company</u>	<u>Cities</u>	<u>Service</u>

NORTH

[illegible]

SOUTH

O. W. P. B.
13

KANSAS
14

Russell
15-W

Sec. _____ Twp. _____ R. _____

Well No. #3 Milberger Farm

Cities Service Company

Barbour Drlg Contractor

Big Creek


330 Ft. from N. Line

_____ Ft. from S. Line

_____ Ft. from E. Line

990 Ft. from W. Line

NE NW NE

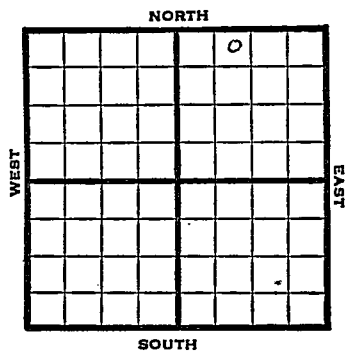

1950 Elev 1858 REPORT

10/11 Location

11/1 Spud 10-9-50
0.1 Well TD 3291'
8" @ 360' Lans. 3020'
Arb. 3258'
5" @ 3269'
TD 3291'
500 A
Comp. 141 BO 54BWPD
COMPLETED

1953
7/29

O. W. P. B.
Oil well TD 3291' Lans 3020'
Arb. 3268' 5" @ 3269 OTD 3291
PB 3256 17/3233-37 6/3324-30
57/3192-3206 21/3058-63 24/3033-39
750 A @ 3224-37 1500 A @ 3192-3206
1000 A @ 3058-63 750 A @ 3033-39
P/288 BW 24 hrs Sq Perf. CO to 3223
65/3192-3206 1500 A 21/3058-63
750 A 24/3033-39 750 A
P/81 BOPD 93 BW Comp.

FIRST REPORT

COMPLETED

County Russell State KansasSec. 13 (Blk.) 14 (Sur.) 15W Map No.Operator Cities ServiceWell No. 3 Farm MilbergerElev. 1858 Location NE NE NE

330 Ft. From N Line NE990 Ft. From W Line Quarter1st. Report OCT 11 1950

Completion

Remarks

Earbourn Drig. - Contr.

Spudding Date

Drlg. Data Big Creek Pool

Location

J. E. TYRA

County Russell State Kansas
 Sec. 13 (Blk.) 14 (Sur.) 15W Map No.
 Operator Cities Service
 Well No. 3 Farm Milberger
 Elev. 1858 Location NE NW NE

330 Ft. From N Line NE
990 Ft. From W Line Quarter
 1st. Report
 Completion NOV 1 1950
 Remarks Big Creek Pool
Barbour Drlg. - Contr.
 Spudding Date 10-9-50

Drlg. Data Oil well TD 3291
8" @ 360 Lans. 3020 Arb. 3268
5" @ 3269 TD 3291 500 A
Comp. 141 bo 54bwpd

J. E. TYRA

0

FIRST REPORT
COMPLETE

Drlg. Data	Oil well	TD 3291
Lens. 3020	Arb. 3268	5" @ 3269
OTD 3291	PB 3256	17/ 3233-37
6/ 3324-30	57/ 3192-3206	21/ 3058-63
24/ 3033-39	750 A @ 3224-37	1500 A @
3192-3206	1000 A @ 3058-63	750 A @
3033-39	P/ 288 bw	24 hr. sq perf.
CO to 3223	65/ 3192-3206	1500 A
21/ 3058-63	750 A	24/ 3033-39 750 A
P/ 81 bopd	93 bw	Comp.

J. G. McGEHEE