


DX 78-1 Russell

KANSAS

Section 13 Township 14 Range 15W

Well No. #1 Nedenthal

Company Chet Loving (Russell)

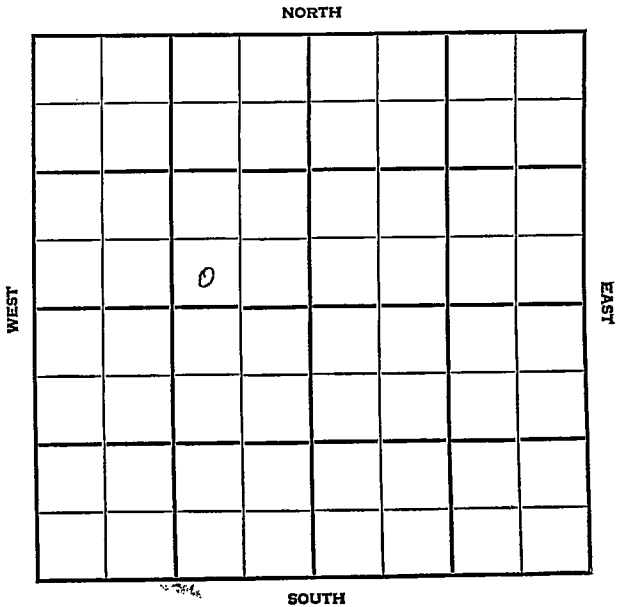

Russell

KANSAS

SEC.

13

TWP.

14

R.

15W

WELL NO.

#1 Nedenthal

FARM

COMPANY

Chet Loving (Russell)

CONTRACTOR

Sierra

Gorham


____ FT. FROM N. LINE

____ FT. FROM S. LINE

____ FT. FROM E. LINE

____ FT. FROM W. LINE

SW SE NW

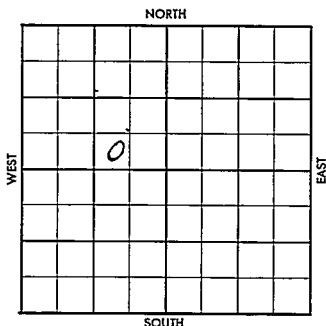

1956

ELEVATION

1830'

REPORT

7-25

Comm. 7-2256

8" @ 873 w/400

Drlg. 1710'

Anh. 864'

8-29

5 1/2" @ 3274

CO 30/3244-49

tst 1 pint oil

S/ 30 BOPEH, no wtr.

After acid; est. P/ 25 bopd, no wtr.

H. 2937'; Tr. 2956'; L. 2991';

Log tops: A. 3242';

TD 3275';

COMPLETED

County Russell Elev. _____
 Sec. 13 Twp. 14 Rge. 15W
 Company Chet Loving (Russell)
 FarmName Nedenthal No. 1

TOPS	DEPTH	LOG	DATUM	Loc. in Sec.
Anh.	<u>86h</u>			<u>SW SE NW</u>
TP.				
H.				
Tr.				
Dg.				
Bl.				
L.				Geol. _____
K.C.				Gentr. _____
B.K.C.				<u>Sierra</u>
Ce.				<u>GORHAM</u>
C.				<u>Gorham</u>
M.				
M.				
K.				
Mz.				
Mo.				
V.				
S.				
S.				
A.				
R.				
PE.				
G.				
T.D.				

JUL 25 1956
 FIRST REPORT

Date Comm. 7-22-56

8W @ 873/1,000 drlg. 1700

2221 100A

County Russell Elev. 183
 Sec. 13 Twp. 14 Rge. 17W
 Company Niet Lovin (Russell)
 Farm Name Wendthal No.

TOPS	DEPTH	LOG	DATUM	Loc. in Sec.
Anb.	061			
TP.				
H.	2937			
Tr.	2956			
Dg.				
BL.				
L.	2991			
K.C.				Geol.
B.K.C.				Contr.
Ce.				Sierra
C.				
M.				Pool
M.				Conham
K.				
Mz.				
Mq.				
V.				
S.				COMPLET
S.				
A.		3242		
R.				
PE.				
G.				
TD.	3275			

Date Comm. 1-22-56

AUG 29 1956

CH 373/170 2070 7770 AUG 1 '56 5 1/2@ 3275 AUG 8 '56 AUG 15 '565 1/2 @ 3274 ca 30/3244-49fst 1 pint oil / 1/2 no fst.AUG 22 '56 Pop. AUG 29 '568 30 Bopano/w after Acid est. p. 25 Bopa
no/w.