

KANSAS

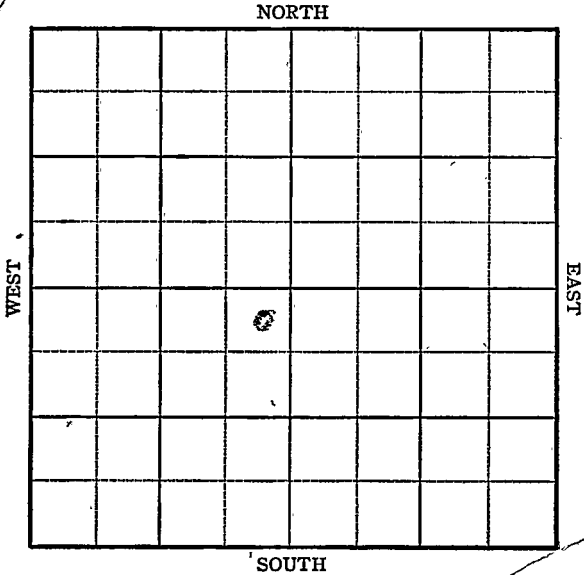
Russell

FORM 51 5M PETROL

Section 13 Township 14 Range 15W

Well No. #2
1 Holland

Company Phil-Han Leystone Pet.



O.W.W.O.

✓

KANSAS

Russell

Sec. 13 Twp. 14 R. 15-W 1

Well No. #2 #1 Holland Farm

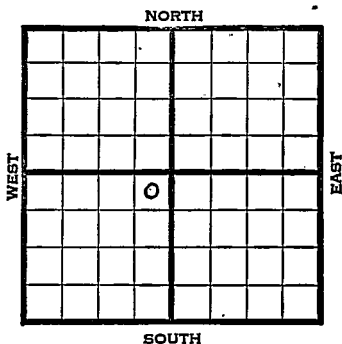
Haystone Pet.
Phil Han Company

330 Ft. from N. Line

 Ft. from S. Line

330 Ft. from E. Line

 Ft. from W. Line



NE SW Elev. 1809

1945

REPORT

8/1 Location

8/8 8" @ 460'
Anhy. 835
Drlg. 2191

8/15 Drlg. 3232

8/22 Lans 2982

Arb. 3228

TD 3232'

ABANDONED

O.W.W.O.

1950

6/7

Lans 2982

S. SO 3018-22

Arb 3228-32T-D

S. So. was D & A

Mim to D. D.

7/26

Lans 2982

SO 3018-22

Arb 3228-32

OTD 3232

TD 3254

5" @ 3275

perf Arb

200 acid HFW

PB 3206, DD 3305, 2500' wtr

DD 3320

Reagen sand 3275, TD 3385, Comp for SWD

100 boph

Completed

COMPLETED

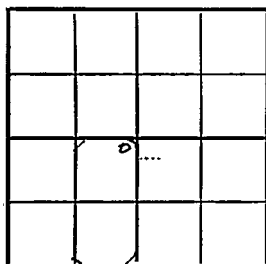
KANSAS
KansasPool Name TrappMap No. 72 Sec. 13 Twp. 14 R. 15WWell No. 1 HollandPhil-Han

Company

FIRST REPORT

Contractor

NE SW

SECTION PLAT330 Ft. from N. Line Ft. from S. Line330 Ft. from E. Line Ft. from W. LineRussell CountyLocation XRig up

Drilling and Remarks:

RECORDCased in., ft.Sand Gas Oil Total Depth **PRODUCTION**1st 24 hrs. Nat. 1st 24 hrs. after shot Gas Cu. Ft.Dry Hole Abandoned

Date

AUG 1 194519S. J. LEWISScout

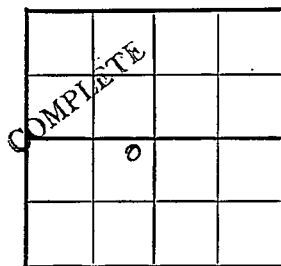
Map No. _____ Sec. 13 Twp. 14 R. 15WWell No. 2 HollandKeystone Petroleum

Company

Contractor

NE NE SW

SECTION PLAT

330 Ft. from N. Line Ft. from S. Line330 Ft. from E. Line330 Ft. from W. LineRussell County

Location _____

Rig up _____

Drilling and Remarks:

Lans. 2982

SO 3018-22

Arb. 3228-32

OTD 3232

5" @ 3275

TD 3254

Perf. Arb.

200 acid HFW

RECORD

Cased _____ in., _____ ft.

Sand _____

Gas _____

Oil _____

Total Depth 3385

PRODUCTION

1st 24 hrs. Nat. _____

1st 24 hrs. after shot _____

Gas _____ Cu. Ft.

Dry Hole _____

Abandoned _____

Date

JUL 26 1950 19J. E. TYRA Scout

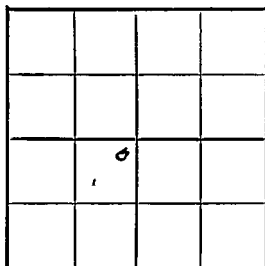
KANSAS

Kans. Pool Name TrappMap No. 72 Sec. 13 Twp. 14 R. 15WWell No. 1 HollandPhil-Han Company

ABANDONED

Contractor

NE SW

E 1/809
SECTION PLAT.330 Ft. from N. Line Ft. from S. Line330 Ft. from E. Line Ft. from W. LineRussell CountyLocation Rig up

Drilling and Remarks:

Lans 2982Acc 3228.

RECORD

Cased in., ft.Sand Gas Oil Total Depth 3222

PRODUCTION

1st 24 hrs. Nat. 1st 24 hrs. after shot Gas Cu. Ft.Dry Hole Abandoned

Date

AUG 22 1945

19

S. J. LEWIS

Scout