
Russell

Form 51—5M—5-34—Palace

Map No. KANSAS Sec. 13 Twp. 14 R. 15W

Well No. 2 Holland Farm

Phillips Pet. Company

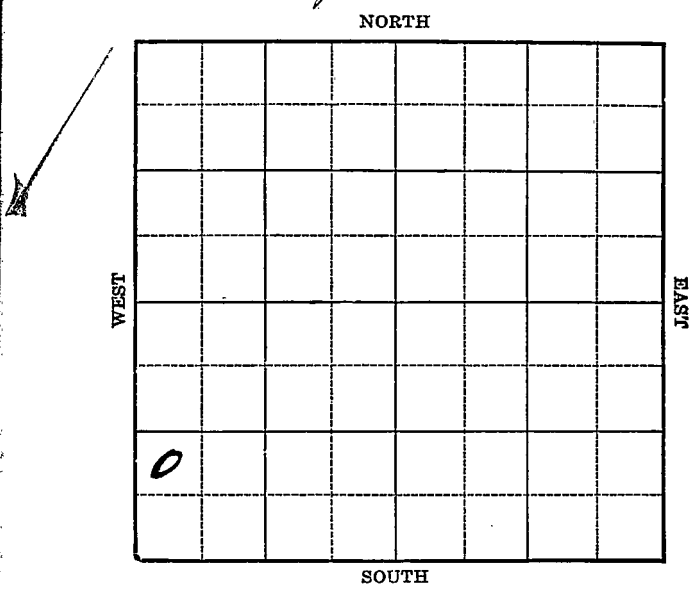

Location

Drilling Remarks

Rig Up

Drilling Remarks

RECORD

Cased ____ in. ____ ft.

Sand

Gas

Oil

Total Depth

PRODUCTION

1st 24 hrs. Nat.

1st 24 hrs. after shot

Gas ____ cu. ft.

Dry Hole

Abandoned

Form 252-A
5M 7-34 MPC

Russell


Map No. KANSAS Sec. 13 Twp. 14 R. 15 W

Well No. 2 Holland Farm

Phillips Pet. Company

990 Ft. from S. Line

330 Ft. from W. Line

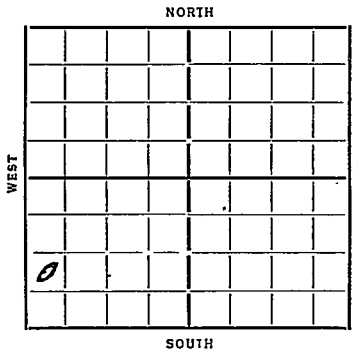

Date 1934	REPORT
12/13	Bldg
12/21	Rgd
12/27	—
1/3/35	Bldg 180 20" 70
1/10	" 730 15½ 475
1/17	" 900 13" 863
1/24	" 1765 Anhy. 861 Salt 1238
1/31	" 2350 10" 1750
2/7	" 2510 8" 2457
2/14	" 2665
2/21	" 2940
2/28	" 3050 Oswald 2980
3/7	6" 3183 Silicous 3228-30
	WR 6"
3/14	3234 TD 2900' oil 12 hrs.
3/20	Silicous 3228 TD 3234
	573 Bbls

COMPLETED

Form 28—1M Blks. 9-28 Russell KANSAS

Map No. 72 Sec. 13 Twp. 14 R. 15W

Well No. 2 - Holland

Phillips Pet. Company

Contractor


FIRST REPORT SECTION PLAT

Ft. from N. Line

990 Ft. from S. Line

Ft. from E. Line

330 Ft. from W. Line

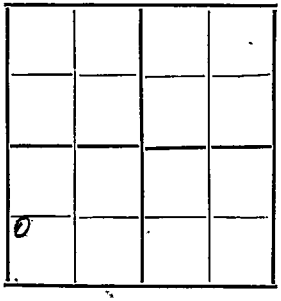

Location

Rig up

Drilling and Remarks:

Beldy

RECORD

Cased in., ft.

Sand

Gas

Oil

Total Depth

PRODUCTION

1st 24 hrs. Nat.

1st 24 hrs. after shot

Gas Cu. Ft.

Dry Hole

Abandoned

Date

12-12-37 192 ORVAL MANNSCHRECK Scout

Form 26—1M Blks. 6-28

Russell

Map No. 77 Sec. 13 Twp. 14 R. 15W


Well No. 2- Holland

Phillips Pet Company

Contractor

COMPLETED

SECTION PLAT

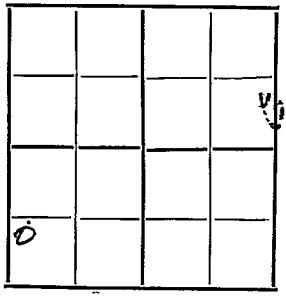

Ft. from N. Line

990 Ft. from S. Line

Ft. from E. Line

330 Ft. from W. Line

Location

Rig up

Drilling and Remarks:

573 bbls

RECORD

Cased in., ft.

~~Sand~~ Siluvian 3228

Gas

Oil

Total Depth 3234

PRODUCTION

1st 24 hrs. Nat.

1st 24 hrs. after shot

Gas Cu. Ft.

Dry Hole

Abandoned

Date

3-20-32 192

ORVAL MAINSCHRECK Scout