

Russell


Form 51—5M—5-34—Palace

Map No. **KANSAS** Sec. *13* Twp. *14* R. *15^w*

Well No. *1 Holland* Farm

Phillips Pet Company

NORTH

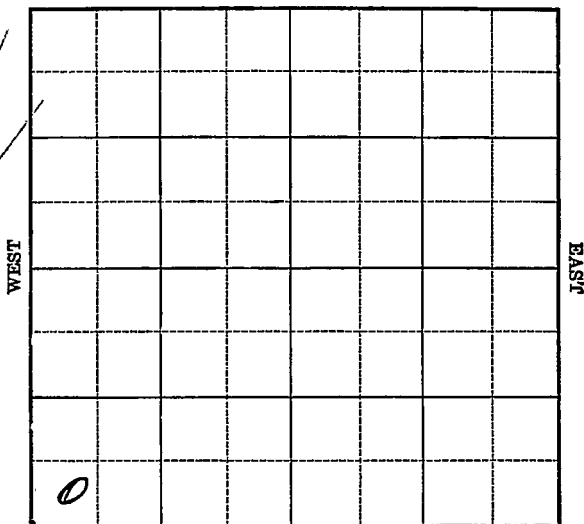

SOUTH

Location

Drilling Remarks

Rig Up

Drilling Remarks

RECORD

Cased in. ft.

Sand

Gas

Oil

Total Depth

PRODUCTION

1st 24 hrs. Nat.

1st 24 hrs. after shot

Gas cu. ft.

Dry Hole

Abandoned

Russell


Map No. KANSAS Sec. 13 Twp. 14 R. 15^w
Well No. 1 Holland Farm
Phillips Pet. Company

 Ft. from N. Line

330 Ft. from S. Line

 Ft. from E. Line

330 Ft. from W. Line

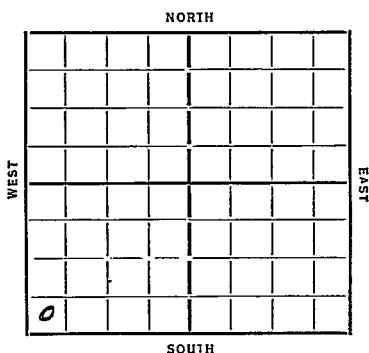

Date 1934 REPORT

9/19 Material
9/27 Rig
10/4
10/11 Spud
10/18 Sly 1600 10" 252
10/25 " 2954
11/1 Saturation 3197-98 1/2
 7" 3225 3220
11/8 Silicious ~~3225~~ Cum 6" 3225
 Beeling
11/15 Silicious 3220 Corrected
 TN 3225 HFO 18 hrs.
11/21 Silicious 3220 TN 3225
 555 Bbls.

COMPLETED

Map No. 72 Sec. 13 Twp. 14 R. 15WWell No. #1- HollandPhillips Pet Company

Contractor

SECTION PLAT

____ Ft. from N. Line

330 Ft. from S. Line

____ Ft. from E. Line

330 Ft. from W. Line

FIRST REPORTS

Location _____

Rig up _____

Drilling and Remarks:

Material

RECORD

Cased _____ in., _____ ft.

Sand _____

Gas _____

Oil _____

Total Depth _____

PRODUCTION

1st 24 hrs. Nat. _____

1st 24 hrs. after shot _____

Gas _____ Cu. Ft.

Dry Hole _____

Abandoned _____

Date

9-19-34 19

ORVAL MANNSCHRECK

Scout

Map No. 72 Sec. 13 Twp. 14 R. 15W


Well No. 1-Holland

Phillips pit Company _____

Contractor _____

COMPLETED

SECTION PLAT

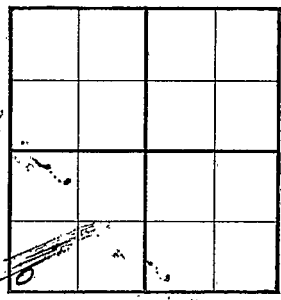

_____ Ft. from N. Line,

330 Ft. from S. Line

_____ Ft. from E. Line

330 Ft. from W. Line

Location _____

Rig up _____

Drilling and Remarks:

555 lbs

RECORD

Cased _____ in., _____ ft.

Sand siliceous 3220

Gas _____

Oil _____

Total Depth 3225

PRODUCTION

1st 24 hrs. Nat. _____

1st 24 hrs. after shot _____

Gas _____ Cu. Ft.

Dry Hole _____

Abandoned _____

Date

11-21-37 19

ORVAL MANN SCHRECK

Scout