

Russell

KANSAS

| | | |
|------------|------------|-----------|
| SEC. 13 | TWP. 14 | R. 15W |
|------------|------------|-----------|

WELL NO. #1 Holland FARM

COMPANY Chet Loving

CONTRACTOR Trans-Era


Gorham

_____ Ft. from N. Line

_____ Ft. from S. Line

_____ Ft. from E. Line

_____ Ft. from W. Line

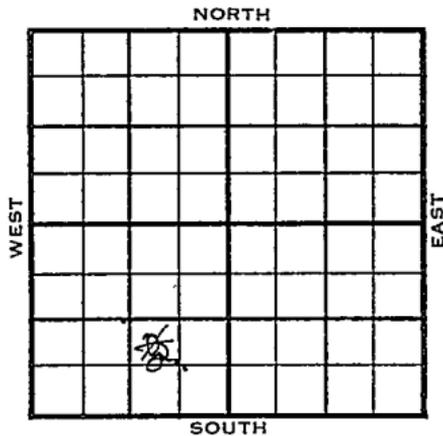

NW SE SW

CW/2

| | ELEVATION | REPORT |
|------|-----------|--------|
| 1956 | 1800' | |

5-2 Comm. 4-28-56
8" @ 845 w/300
Drlg. 1480'

5-29 5 1/2" @ 3218 w/100
CO 3220, FU 200' oil, no/wtr., 1 hr.
P/ 25 BOPD no/wtr.
H. 2918', Tr. 2938', L. 2972',
BKD 3200', A. 3216' #
TD 3220'

COMPLETED

County Russell Elev. _____
 Sec. 13 Twp. 14 Rge. 15W
 Company Chet Loving
 FarmName Holland No. 1

| TOPS | DEPTH | LOG | DATUM |
|--------|-------|-----|-------|
| Anh. | | | |
| Tp. | | | |
| H. | | | |
| Tr. | | | |
| Dg. | | | |
| Bl. | | | |
| L. | | | |
| K.C. | | | |
| B.K.C. | | | |
| Ce. | | | |
| C. | | | |
| M. | | | |
| M. | | | |
| K. | | | |
| Mz. | | | |
| Mo. | | | |
| V. | | | |
| S. | | | |
| S. | | | |
| A. | | | |
| R. | | | |
| Pe. | | | |
| G. | | | |
| T.D. | | | |

Loc. in Sec. NW SE SW
 Geol. _____
 Contr. Trans-Era
 Pool Gorham

MAY 2 '50
 FIRST REPORT

Date Comm. 1-28-56
8" @ 845/300 drlg. 1480

[Handwritten signature and scribbles]

1956

R.G.

Co.
 Lse.
 No.
 Sec.
 T.
 R.

