


Section 13 Township 14 Range 15-W

Well No. #2 Neidenthal "B"

Company Raymond & Lebow

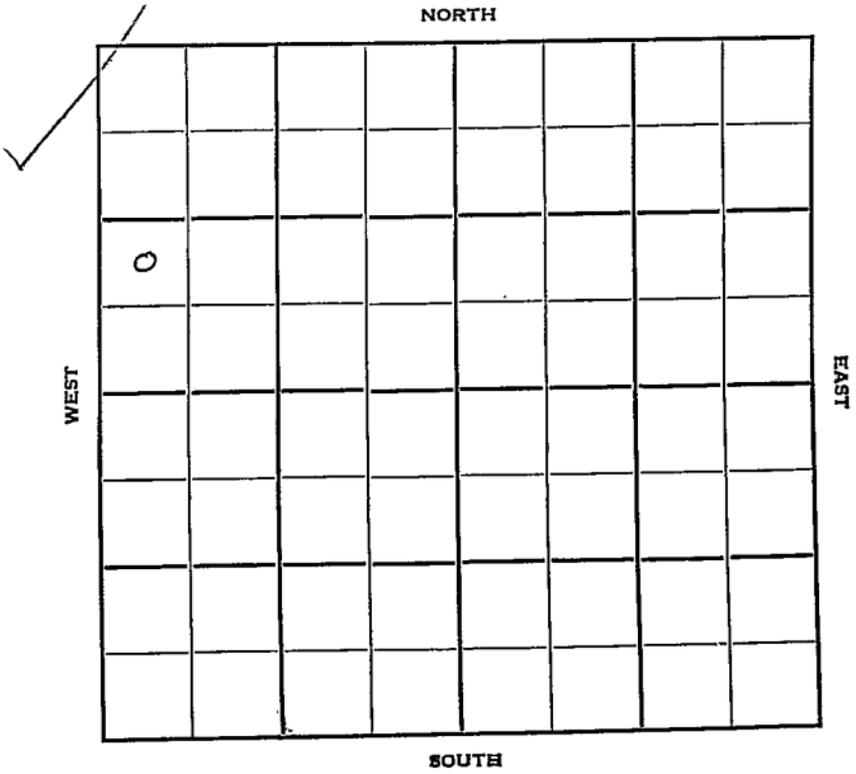

✓

Russell

KANSAS

Sec. 13 Twp. 14 R. 15W

Well No. #2 Neidenthal "B" Farm

Raymond & Lebow Company

Raymond & Lebow Contractor

Trapp Pool


\_\_\_\_\_ Ft. from N. Line

990' Ft. from S. Line

\_\_\_\_\_ Ft. from E. Line

330' Ft. from W. Line

NW SW NW

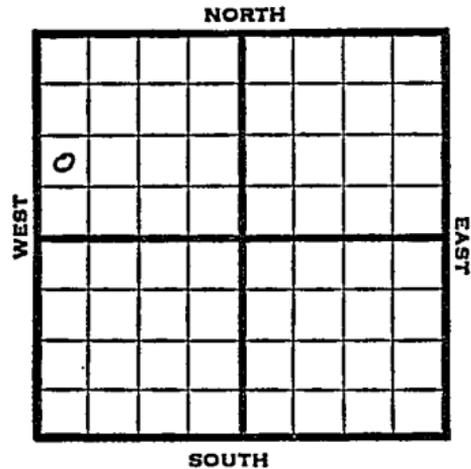

1950

Elev. 1854' REPORT

9/6

Location

9/27

Spud 9-5-50

Oil Well TD 3272

8-5/8" @ 895'

Anhy 889' KG 3020

TD 3272

5" @ 3267

200 A

S/7 BOPH

Comp. 50 BOPD 5% wtr.

COMPLETED

County Russell State Kansas

Sec. 13 (Blk. Twp.) 14 (Sur. Rge.) 15W Map No.

Operator Raymond & Lebow

Well No. 2 Farm Weidenthal "B"

Elev. \_\_\_\_\_ Location NW SW NW

0					

990 Ft. From S Line NW

530 Ft. From W Line Quarter

Ist. Report SEP 6 1950

Completion \_\_\_\_\_

Remarks \_\_\_\_\_

Spudding Date \_\_\_\_\_

Drlg. Data Trapp Pool

Location

County Russell State Kansas

Sec. 13 (Blk. Twp.) 14 (Sur. Rge.) 15W Map No.

Operator Raymond & Lebow

Well No. 2 Farm Neidenthal "B"

Elev. 1854 Location NW SW NW


990 Ft. From S Line NW

330 Ft. From W Line Quarter

1st. Report

Completion SEP 27 1950

Remarks Trapp Pool

Raymond & Lebow Drlg.

Spudding Date 9-5-50

Drlg. Data Oil well TD 3272

8 5/8" @ 895 Anhy 889 KC 3020

TD 3272 5" @ 3267 . 200A S/ 7 boph

Comp. 50 bopd 5% water

**COMPLETE**