

Section 13 Township 14 Range 15W

Well No. #1 Neidenthal "B"

Company Raymond & Lebow

NORTH

0									

WEST

EAST

SOUTH

Sec. 13 Twp. 14 R. 15W

Well No. #1 Neidenthal "B" Farm

Raymond & Lebow Company

Raymond & Lebow Contractor

Big Creek Pool


Ft. from N. Line

330' Ft. from S. Line

Ft. from E. Line

330' Ft. from W. Line

SW SW NW

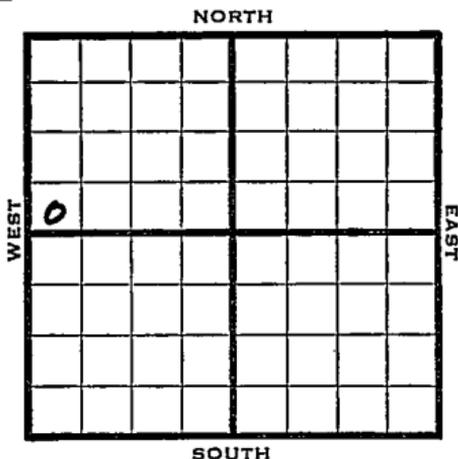

1950

Elev. 1850' REPORT

8/23

RUR.

9/27

Spud 8-24-50

Oil Well TD 3268'

8" @ 888' Heeb. 2965'

Lans. 3019' Arb. 3258-68

5" @ 3264' TD 3268

200 A S/29 BO 1 1/2 hr

Comp. 50 BOPH 5% wtr.

**COMPLETED**

County Russell State Kansas

Sec. 13 (Blk. Twp.) 14 (Sur. Rge.) 15W Map No.

Operator Raymond & Lebow

Well No. 1 Farm Weidental "B"

Elev. \_\_\_\_\_ Location SW SW NW


330 Ft. From S Line NW

330 Ft. From W Line Quarter

1st. Report AUG 23 1950

Completion \_\_\_\_\_

Remarks \_\_\_\_\_

Spudding Date \_\_\_\_\_

Drig. Data Big Creek Pool

RUR

County Russell State Kansas

Sec. 13 (Blk. 14 (Sur. 15W Map No. (Twp.))

Operator Raymond & Lebow

Well No. 1 Farm Neidenthal "B"

Elev. 1850 Location SW SW NW


330 Ft. From S Line NW

330 Ft. From W Line Quarter

1st. Report

Completion SEP 27 1950

Remarks Big Creek Pool

Raymond & Lebow Drlg.-Cont

Spudding Date 8-24-50

Drlg. Data Oil well TD 3268

8" @ 888 Leeb. 2965 Lans. 3019

Arb. 3258-68 5" @ 3264 TD 3268 200 A

S/ 29 bo 1½ hr. Comp. 50 bopd 5% water

J. E. TYRA