
FORM 51 25M 8-50 WESTERN Russell KANSAS

Section 13 Township 14 Range 14W

Well No. #3 Bowlus

Company Murfin Drlg.

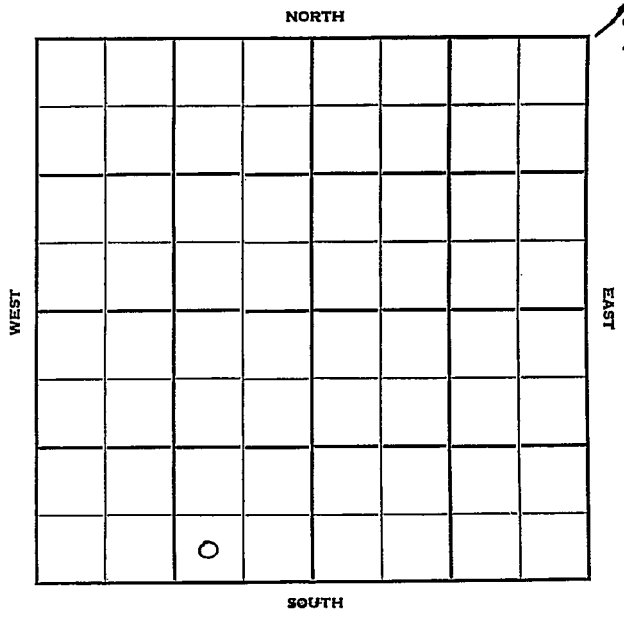

FORM 252-B
10M 8-51 TPCO.

Russell

KANSAS

Sec. 13 Twp. 11 R. 11W

Well No. #3 Bowles Farm

Murfin Drlg. Company

Murfin Contractor


Ft. from N. Line

330 Ft. from S. Line

990 Ft. from E. Line

Ft. from W. Line

SW SE SW

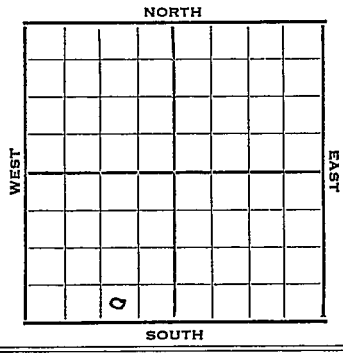

1952	Elev. 1788' REPORT
5/7	Cellar & pits
5/14	MI
5/21	Drlg. 23
5/28	12" @ 320' 10" @ 475' Anhy 746' 8" @ 754' Drlg. 1045'
6/11	Tarkio 2340' 7" @ 2341 DD 2348' Set pipe
6/18	DP 2348' PB 2346' D-Hyd.
6/25	Spud 5-19-52 Oil Well TD 2348' 12" @ 320' 10" @ 475' Anhy 746' 8" @ 754 Tar. 2340 7" @ 2341 TD 2348 PB 2346 D-Hydro Comp. 30 b opd

COMPLETED

FORM 275 FOR SALE BY KANSAS BLUE PRINT CO.


County Russell State Kansas

Sec. 13 (Blk. Twp.) 14 (Sur. Rge.) 14W Map No.

Operator Murfin D & Lg.

Well No. 3 Farm Bowlus

Elev. Location SW SE SW

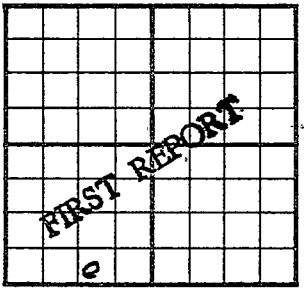

330 Ft. From S Line SW

990 Ft. From E Line Quarter

1st. Report MAY 7 1952

Completion

Remarks

Murfin - Contr.

Spudding Date

Drlg. Data

Cellar & pits

J. G. McGEHEE

FORM 275 FOR SALE BY KANSAS BLUE PRINT CO.


County Russell State Kansas

Sec. 13 (Blk. Twp.) 14 (Sur. Rge.) 14W Map No.

Operator Murfin Drlg.

Well No. 3 Farm Bowlus

Elev. 1788 Location SW SE SW

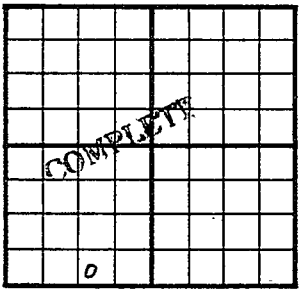

330 Ft. From S Line SW

990 Ft. From E Line Quarter

1st. Report

Completion JUN 2 5 1952

Remarks

Murfin Drlg. - Contr.

Spudding Date 5-19-52

Drlg. Data Oil well TD 2348

12" @ 320 10" @ 475 Anhy 746 8" @ 754

Tarkio 2340 7" @ 2341 TD 2348

PB 2346 D-Hydro. Comp. 30 bopd

J. G. McGEHEE