

KANSAS


FORM 51 25M 3-49 PETROL

Russell

Section 13 Township 14 Range 11W

Well No. #4 S Hildebrandt

Company Murfin Drlg. Company

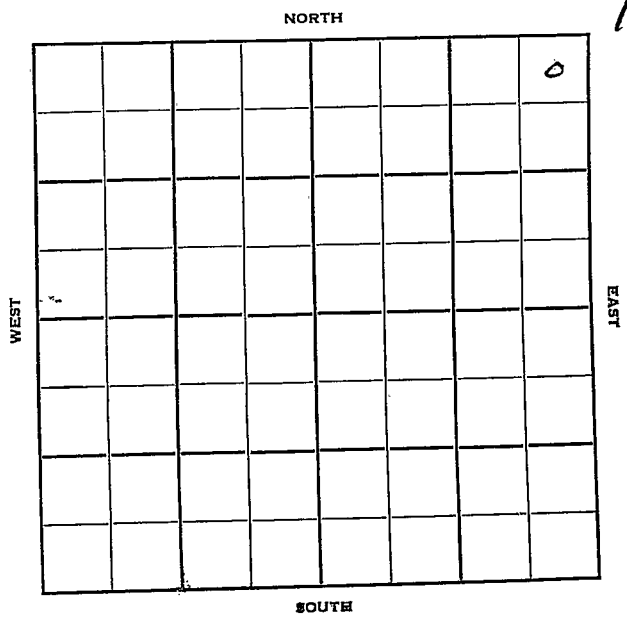

Sec. 13 Twp. 14 R. 14 W

Well No. #4 ~~#3~~ Hildebrandt Farm

Murfin Drlg. Company

Murfin Drlg. Contractor


330 Ft. from N. Line

_____ Ft. from S. Line

330 Ft. from E. Line

_____ Ft. from W. Line

NE NE NE

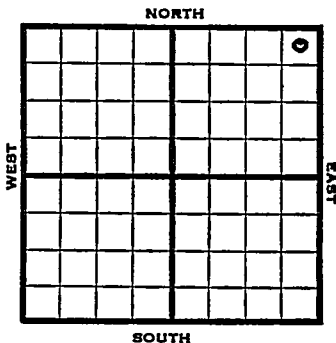

1953

Elev. 1836'

REPORT

3/18

RUCT

3/26

13" @ 326

10" @ 502

Anhy 817'

4/2

8" @ 826

Drlg. 2000'

4/9

D & A

4/16

"

4/22

Spud 3-17-53

D & A TD 2440

13" @ 326 10" @ 502

8" @ 826 Tarkio 2371

Howard 2425 TD 2440

Anhy 817

2nd Tarkio 2393

D & A

ABANDONED

Map No. _____ Sec. 13 Twp. 14 R. 14W

Well No. 4 Hildebrand

Murfin Drlg. Company

CORRECTION

Contractor

NE NE NE

SECTION PLAT

			o

330 Ft. from N. Line

_____ Ft. from S. Line

330 Ft. from E. Line

_____ Ft. from W. Line

Russell County

Location _____

Rig up _____

Drilling and Remarks:

Reported
#3 Hildebrand

RECORD

Cased _____ in., _____ ft.

Sand _____

Gas _____

Oil _____

Total Depth _____

PRODUCTION

1st 24 hrs. Nat. _____

1st 24 hrs. after shot _____

Gas _____ Cu. Ft.

Dry Hole _____

Abandoned _____

Date

MAR 1 8 1953

J. G. McGEHEE Scout

