

Russell
14-W ✓

Sec. 13

KANSAS
Twp.

R. 14-W

Well No. #1 Bowlus Farm

I. W. Murfin et al Company


Hall-Gurney Pool

~~330'~~ Ft. from N. Line

330' Ft. from S. Line

330' Ft. from E. Line

_____ Ft. from W. Line

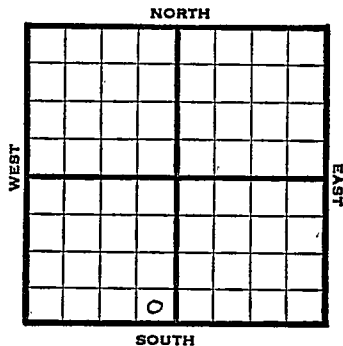

SE SW

1947		Elev. 1777'	REPORT
11/12	Rig		
11/19	"		
11/25	"		
12/3	"		
12/10	"		
12/17	"		
12/30	12" @ 405'		
	10" @ 754'		
	Drlg. 1325'		
1948			
1/7	Drlg. 1935'		
1/14	Tarkio 2299'		
	8" @ 2291'		
	Drlg 2315' 400' oil 12 hrs		
1/21	"		
1/26	"		
2/4	"		
2/11	"		
2/18	"		
2/25	"		
3/3	"		
3/10	"		
3/17	"		

OVER

1948

3/24 Terkio 2299'
8" @ 2291'
Drig 2315' 400' oil 12 hrs.

3/31 "

4/7 "

4/14 "

4/21 Pump 25 bbls oil PH, 3 hrs,

4/28 "

5/5 Tarkio 2299'
8" @ 2291'
Pump 15 oil Pot.
Gr. 40°
TD 2315'

COMPLETED

Map No. _____ Sec. 13 Twp. 14 R. 14W

Well No. 1 Bowlus

I. W. Murfin et al. Company

FIRST REPORT

Contractor

SE SW


SECTION PLAT

_____ Ft. from N. Line

330 Ft. from S. Line

330 Ft. from E. Line

_____ Ft. from W. Line

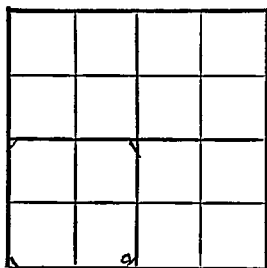

Russell County

Location _____

Rig up _____

Drilling and Remarks:

Rig

RECORD

Cased _____ in., _____ ft.

Sand _____

Gas _____

Oil _____

Total Depth _____

PRODUCTION

1st 24 hrs. Nat. _____

1st 24 hrs. after shot _____

Gas _____ Cu. Ft.

Dry Hole _____

Abandoned _____

Date

NOV 12 1947 19

S. J. LEWIS Scout

Wm

- Misc. Small Maps
- Carés
- Tracing
- France Map
- Scarborough Map
- Pierce Map
- Cecological Dept.
- Pierce Flat Dock

Wm Jr

177
178
179

180
181
182

A

183
184
185
186

187
188

Misc. Small Maps	
Cards	
Tracing	
France Map	
Scarborough Map	
Pierce Map	
Geological Dept.	
Pierce Plat Book	

189
190