

Section 13 Township 14 Range 15W

Well No. #3 E. Neidenthal

Company Earl Wakefield

NORTH

✓

		0					

WEST

EAST

SOUTH

✓

KANSAS

Russell County


Sec. 13 Twp. 14 R. 15W

Well No. #3 E. Neidenthal Farm

Earl Wakefield Company

NW SE NW

NORTH

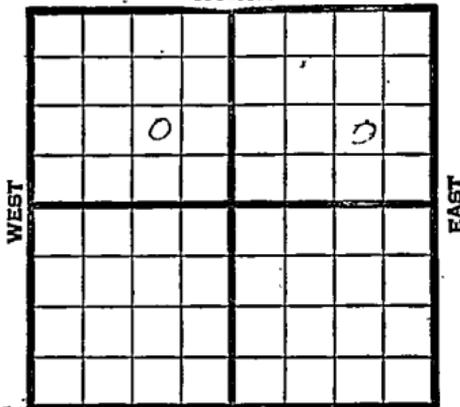

\_\_\_\_\_ Ft. from N. Line

990 Ft. from S. Line

990 Ft. from E. Line

\_\_\_\_\_ Ft. from W. Line

NW SE NW Ele. 1835 SOUTH

1945

REPORT

3/28	Cable rig	
4/5	Rigging up	
4/12	" "	
4/20	Spud	
4/27	12" @ 550	
	Anhy 863	
	10" @ 866	
	Drlg. 1725	
5/3	Drlg. 2250	
5/10	Lans 3018	
	7" @ 3019	
	TD 3027' SO	
5/17	7" @ 3100	
	Drlg. 3240	
5/24	Shut down	
5/29	Lans	3018
	7" @ 3100	Arb. 3247
	5" @ 3250	
	TD 3260	
	Pump 100 Pot.	
	Grav. 39.0	

COMPLETED



Kansas Pool Name Big CreekMap No. 72 Sec. 13 Twp. 14 R. 15WWell No. 3 E. NeidenthalEarl Wakefield CompanyCOMPLETED Contractor

NW SE NW

E 11835  
SECTION PLAT       Ft. from N. Line990 Ft. from S. Line990 Ft. from E. Line       Ft. from W. Line

	0		

Russell County

Location: \_\_\_\_\_

Rig up \_\_\_\_\_

Drilling and Remarks:

Lans 30187" @ 31005" @ 3258Co 73247Pump 100 P.D.39° 34'

## RECORD

Cased \_\_\_\_\_ in., \_\_\_\_\_ ft.

Sand \_\_\_\_\_

Gas \_\_\_\_\_

Oil \_\_\_\_\_

Total Depth 3260

## PRODUCTION

1st 24 hrs. Nat. \_\_\_\_\_

1st 24 hrs. after shot \_\_\_\_\_

Gas \_\_\_\_\_ Cu. Ft.

Dry Hole \_\_\_\_\_

Abandoned \_\_\_\_\_

Date

MAY 29 1945

19

S. J. LEWIS

Scout