

Section 14 Township 14 Range 15W

Well No. #1 Polcyn

Company Jones, Shelborne & Farmer

NORTH

WEST

EAST

							6

SOUTH

Russell

KANSAS
15W

Sec. 14 Twp. 14 R. 15W

Well No. #1 Polcyn Farm

Jones, Shelborne & Farmer Company

Jones, Shelborne & Farmer Contractor

Trapp Pool


Ft. from N. Line

330' Ft. from S. Line

330' Ft. from E. Line

Ft. from W. Line

SE SE NE

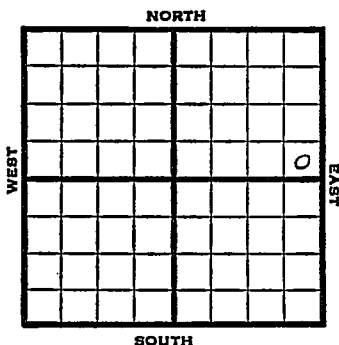

1951 Elev. 1844 REPORT

1/3 Cellar & Pits

3/28 Spud 1-16-51

Oil well TD 3268'
20" @ 70 10" @ 890 Tarkio 2400'
Top. 2825' KC 3010
7" @ 3010 Gr. Sand 3245-68'
FU 300' oil 1 hr. 5" @ 3248
TD 3268'
Comp. 64 BOPD

COMPLETED

County Russell State Kansas
 Sec. 14 (Blk.) 14 (Sur.) 15W Map No.
 Operator Jones, Shelborne & Farmer
 Well No. 1 Farm Polcyn
 Elev. _____ Location SE SE NE

330 Ft. From S Line NE
330 Ft. From E Line Quarter
 Ist. Report JAN 3 1951

Completion _____

Remarks _____

Jones, Shelborne & Farmer


Spudding Date _____

Drlg. Data Trapp Pool

Cellar & pits

J. E. TYRA

County Russell State Kansas
 Sec. 14 (^{Blk.}Twp.) 14 (^{Sur.}Rge.) 15W Map No. _____
 Operator Jones, Shelborne & Farmer
 Well No. 1 Farm Polcyn
 Elev. 1844 Location SE SE NE

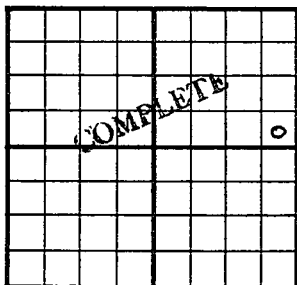

330 Ft. From S Line NE
330 Ft. From E Line Quarter
 Ist. Report _____
 Completion MAR 28 1951
 Remarks Trapp Pool
Jones, Shelborne & Farmer
 Spudding Date 1-16-51

Drlg. Data Oil well TD 3268
20" @ -70 10" @ 890 Tarkio 2400
Top. 2825 KC 3010 7" @ 3010
Gr. sand 3245-68 FU 300' oil 1 hr.
5" @ 3248 TD 3268 Comp. 64 bopd

J. E. TYRA