


Section 14 Township 14 Range 15-WWell No. #2 PolcynCompany J.C. Shaffer

NORTH

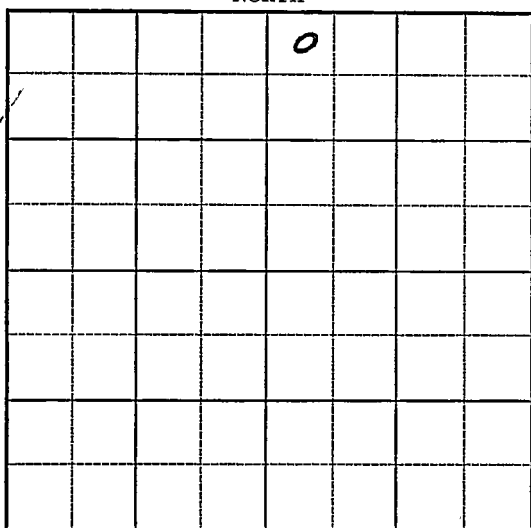


SOUTH



Sec. 14 Twp. 14 R. 15-WWell No. #2 Polcyn FarmJ. C. Shaffer Company330 Ft. from N. Line Ft. from S. Line Ft. from E. Line330 Ft. from W. Line

Elev. 1858

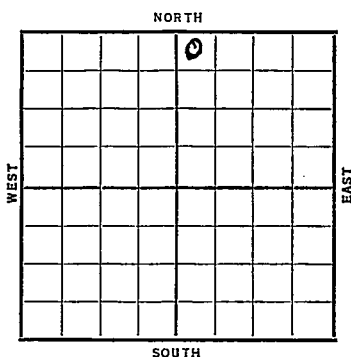

Date

REPORT

1937

10/27

C. R.

11/5

R. U.

11/12

12" @ 583'. WOC.

11/19

Drlg. 1850'.

11/26

Anhy 895'. 10" @ 903'.

12/3

8" @ 2511'. Drlg. 2515'.

12/3

Topeka 2735'. K.O. 3015'.

12/3

2 BW 3005-15'. 7" @ 3017'.

12/10

T.D. 3085'. No shows. C. O.

12/10

7" @ 3254'. Gorham 3268'.

12/10

T.D. 3271'. 1200' oil 10 hrs.

12/15

7" @ 3254'.

12/15

Gorham 3268'.

12/15

T.D. 3272'.

12/15

Swab 5 bbls. oil & lots of

12/15

water 8 hrs.

ABANDONED

Russell

KANSAS

Map No. _____ Sec. 14 Twp. 14 R. 15WWell No. 2 PolcynJ. C. Shaffer

Company

Contractor

FIRST REPORT

NW NE

330 Ft. from N. Line

_____ Ft. from S. Line

_____ Ft. from E. Line

330 Ft. from W. Line

SECTION PLAT

		0	

Location _____

Rig up _____

Drilling and Remarks:

CR

RECORD

Cased _____ in., _____ ft.

Sand _____

Gas _____

Oil _____

Total Depth _____

PRODUCTION

1st 24 hrs. Nat. _____

1st 24 hrs. after shot _____

Gas _____ Cu. Ft.

Dry Hole _____

Abandoned _____

Date

OCT 27 1937

19

H. D. Hatfield

Scout

Russell KANSAS

Map No. 72 Sec. 14 Twp. 14 R. 15WWell No. 2 PolcynJ. C. Shaffer

Company

Contractor

ABANDONED

NW NE

330 Ft. from N. Line

_____ Ft. from S. Line

_____ Ft. from E. Line

330 Ft. from W. Line

SECTION PLAT

		0	

Location _____

Rig up _____

Drilling and Remarks:

swb 5 bbls oil &
 Lots of water - 8 hrs

D & A

RECORD

Cased 7 in., 3254 ft.Sand Gorham 3268

Gas _____

Oil _____

Total Depth 3272

PRODUCTION

1st 24 hrs. Nat. _____

1st 24 hrs. after shot _____

Gas _____ Cu. Ft.

Dry Hole _____

Abandoned _____

Date

DEC 15 1937 19H. D. Hatfield

Scout