


Russell

Map No. 2743.3.12 Sec. 14 Twp. 14 R. 15W

Well No. 3-Neidenthal Farm
Gypsy Oil Company

 Ft. from N. Line
990 Ft. from S. Line
330 Ft. from E. Line
 Ft. from W. Line

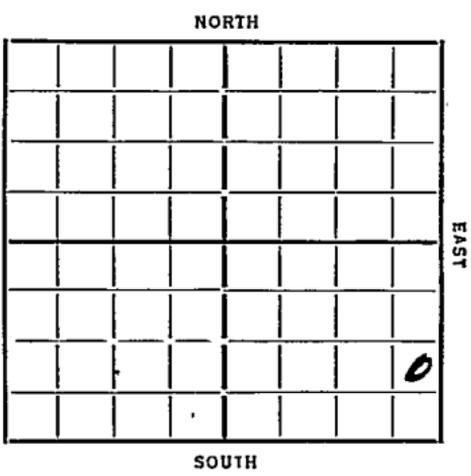

Elev. 1847

Date	REPORT
5/28	Location
6/6	Blky
6/18	Splic 20" 83
6/20	Blg 490 15 1/2 396
6/28	" 915
7/3	" 1620
7/11	" 2135
7/18	" 2575 10" 2526
8/8	Ab 3256 6" 3257 20. 3260 P.P.P.
8/14	Ab 3256 T7 3265 583 Oil 125 Water
	COMPLETED

Map No. R72 Sec. 14 Twp. 14 R. 15W

Well No. 3-Weidenthal

Myers Oil Company

Contractor

FIRST REPORTS

SECTION PLAT

			0

..... Ft. from N. Line

990 Ft. from S. Line

330 Ft. from E. Line

..... Ft. from W. Line

Location

Rig up

Drilling and Remarks:

RECORD

Cased in ft.

Sand

Gas

Oil

Total Depth

PRODUCTION

1st 24 hrs. Nat.....

1st 24 hrs. after shot.....

Gas..... Cu. Ft.

Dry Hole.....

Abandoned.....

Date

5-27-32

ORVAL MANNSCHRECK

Scout

Map No. 72 Sec. 14 Twp. 14 R. 15W

Well No. 3-Neidenthal

Gypsy oil Company

Contractor

~~RECORDED~~

SECTION PLAT

			0

.....Ft. from N. Line

990 Ft. from S. Line

330 Ft. from E. Line

.....Ft. from W. Line

Location.....

Rig up.....

Drilling and Remarks:

583 oil
125 water

RECORD

Cased..... in., ft.

Sand oil 3256

Gas.....

Oil.....

Total Depth 3265

PRODUCTION

1st 24 hrs. Nat.....

1st 24 hrs. after shot.....

Gas..... Cu. Ft.

Dry Hole.....

Abandoned.....

Date

8-14-35 192

ORVAL MANNSCHECK

Scout