

# KANSAS


FORM 51 5M 2-38 TPCO.

Russell

Section 14 Township 14 Range 15-W

Well No. 1 Polcyn

Company A. H. Witt

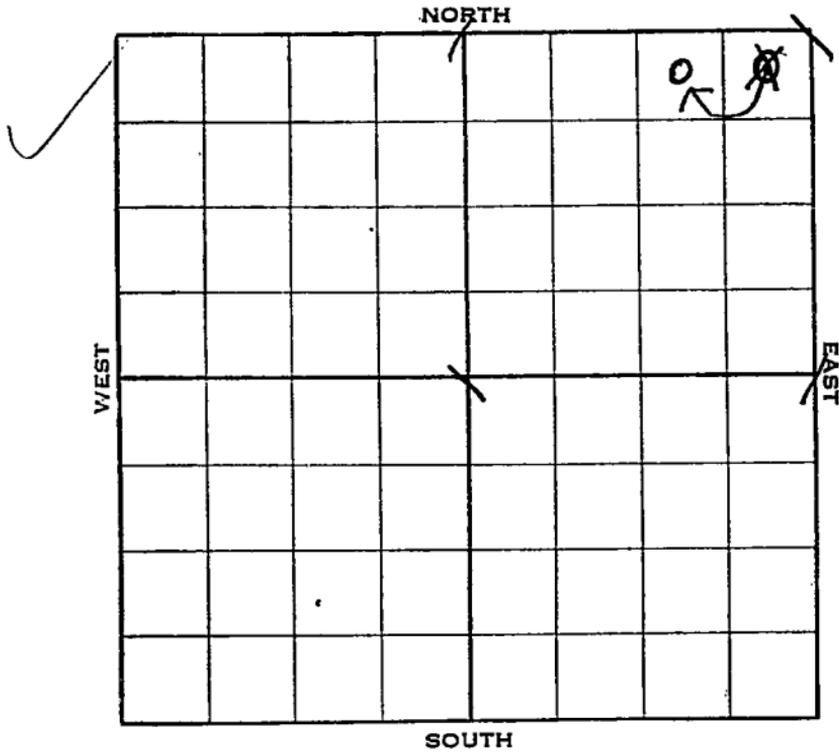

Sec. 14 Twp. 14 R. 15-W

Well No. #1 Polcyñ Farm \_\_\_\_\_

A. H. Witt Company \_\_\_\_\_


330 Ft. from N. Line

\_\_\_\_\_ Ft. from S. Line

990  
~~330~~ Ft. from E. Line

\_\_\_\_\_ Ft. from W. Line

Elev. 1859

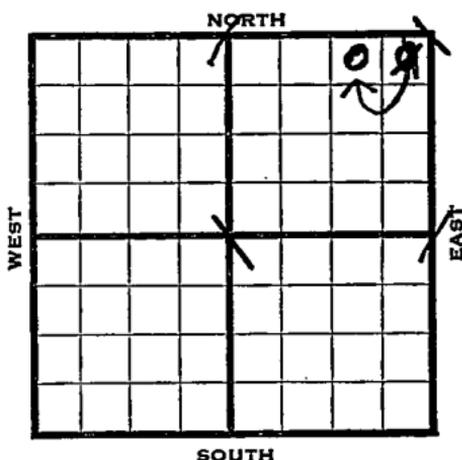

1938	REPORT
5/18	Mat'l.
5/27	B.C.R.
6/3	20" @ 21'.
	Drlg. 110'.
6/10	15" at 395'. 12" at 595'.
	10" @ 900'. Drlg. 935'.
6/17	Anhy 889' - Drlg. 2060'.
6/24	8" @ 2578'. T.D. 2605'. U. R.
7/1	Topeka 2750 8" -2754'
	K.C. 3027' 7" - 3050'
	Sm.-S.O. 3055-57 - Drlg. 3120'
7/8	Arb. 3282'. T. D. 3285'.
	7" - 3278'. WOO.
7/15	" " "
	" " "
7/20	7" - 3278'.
	Arb. 3282'.
	T. D. 3285'.
	1½ BWPH.
	No oil.
ABANDONED	

Map No. 72 Sec. 14 Twp. 14 R. 15W

Well No. 1 Polcyn

A. H. Witt Company

**FIRST REPORT**

**NE/C**

330 Ft. from N. Line

\_\_\_\_\_ Ft. from S. Line

330 Ft. from E. Line

\_\_\_\_\_ Ft. from W. Line

Contractor  
*TRANSWESTERN*  
*FARM-OUT*  
**SECTION PLAT**

			0

Location \_\_\_\_\_

Rig up \_\_\_\_\_

Drilling and Remarks:

**MATL.**

**RECORD**

Cased \_\_\_\_\_ in., \_\_\_\_\_ ft.

Sand \_\_\_\_\_

Gas \_\_\_\_\_

Oil \_\_\_\_\_

Total Depth \_\_\_\_\_

**PRODUCTION**

1st 24 hrs. Nat. \_\_\_\_\_

1st 24 hrs. after shot \_\_\_\_\_

Gas \_\_\_\_\_ Cu. Ft.

Dry Hole \_\_\_\_\_

Abandoned \_\_\_\_\_

Date

MAY 18 1938 19 \_\_\_\_\_ H. D. Hatfield Scout

Russell KANSAS

Map No. 72 Sec. 14 Twp. 14 R. 15<sup>W</sup>Well No. 1-PalmyraG. H. Witt Company

Contractor

NW NENE

## SECTION PLAT

			<u>95</u>

330 Ft. from N. Line

CORRECTION

\_\_\_\_\_ Ft. from S. Line

990 Ft. from E. Line

\_\_\_\_\_ Ft. from W. Line

Location \_\_\_\_\_

Rig up \_\_\_\_\_

Drilling and Remarks:

*first reported  
as being  
located in  
n/c - corrected  
to n/w nene*

## RECORD

Cased \_\_\_\_\_ in., \_\_\_\_\_ ft.

Sand \_\_\_\_\_

Gas \_\_\_\_\_

Oil \_\_\_\_\_

Total Depth \_\_\_\_\_

## PRODUCTION

1st 24 hrs. Nat. \_\_\_\_\_

1st 24 hrs. after shot \_\_\_\_\_

Gas \_\_\_\_\_ Cu. Ft.

Dry Hole \_\_\_\_\_

Abandoned \_\_\_\_\_

Date

MAY 25 1938 19

E. D. Hatfield

Scout

Russell KANSAS

Map No. 72 Sec. 14 Twp. 14 R. 15WWell No. 1 PolcynA. H. Witt Company

Contractor

ABANDONED

NW NE NE

330 Ft. from N. Line

\_\_\_\_\_ Ft. from S. Line

990 Ft. from E. Line

\_\_\_\_\_ Ft. from W. Line

## SECTION PLAT

			0

Location \_\_\_\_\_

Rig up \_\_\_\_\_

Drilling and Remarks:

1 1/2 BW P.H.No oilDYA

## RECORD

Cased 7 in., 3288 ft.Sand Arb 3282

Gas \_\_\_\_\_

Oil \_\_\_\_\_

Total Depth 3285

## PRODUCTION

1st 24 hrs. Nat. \_\_\_\_\_

1st 24 hrs. after shot \_\_\_\_\_

Gas \_\_\_\_\_ Cu. Ft.

Dry Hole \_\_\_\_\_

Abandoned \_\_\_\_\_

Date

JUL 20 1938 19H. D. Hatfield Scout