


Map No. **KANSAS** Sec. 14 Twp. 14 R. 15<sup>w</sup>

Well No. 50 Polycarpus Farm \_\_\_\_\_  
J. C. Shaffer Company \_\_\_\_\_

NORTH

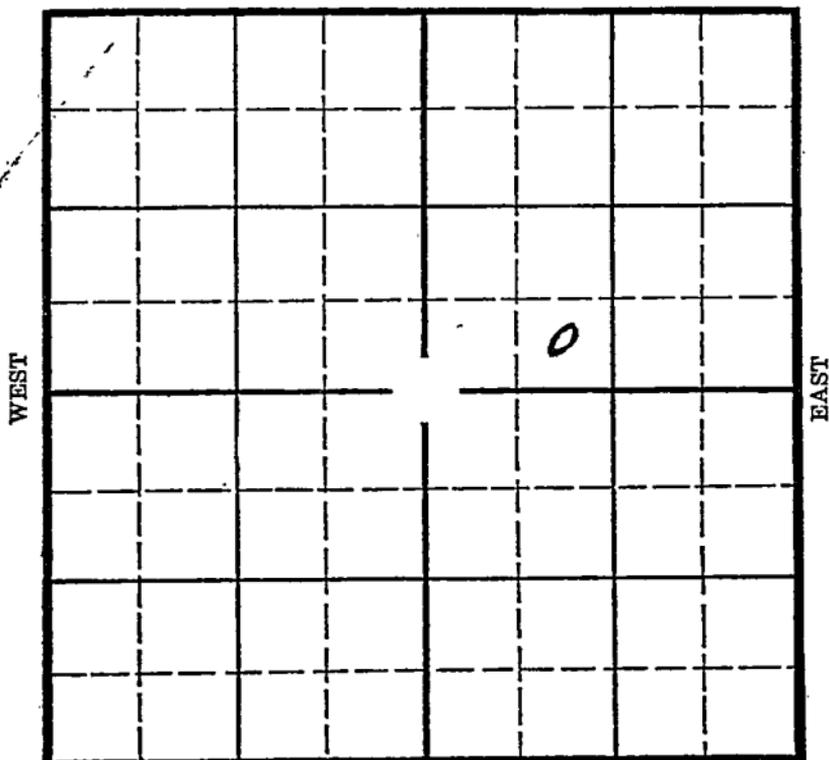

SOUTH

Location \_\_\_\_\_  
Drilling Remarks \_\_\_\_\_

Rig Up \_\_\_\_\_  
Drilling Remarks \_\_\_\_\_

\_\_\_\_\_  
 \_\_\_\_\_  
**RECORD**

**PRODUCTION**

Cased \_\_\_\_\_ in. \_\_\_\_\_ ft.  
 Sand \_\_\_\_\_  
 Gas \_\_\_\_\_  
 Oil \_\_\_\_\_  
 Total Depth \_\_\_\_\_

1st 24 hrs. Nat. \_\_\_\_\_  
 1st 24 hrs. after shot \_\_\_\_\_  
 Gas \_\_\_\_\_ cu. ft. \_\_\_\_\_  
 Dry Hole \_\_\_\_\_  
 Abandoned \_\_\_\_\_

Russell

Map No. KANSAS Sec. 14 Twp. 14 R. 15<sup>w</sup>


Well No. #1 Polym Farm  
J.C. Shaffer Company

\_\_\_\_\_ Ft. from N. Line

330 Ft. from S. Line

\_\_\_\_\_ Ft. from E. Line

990 Ft. from W. Line

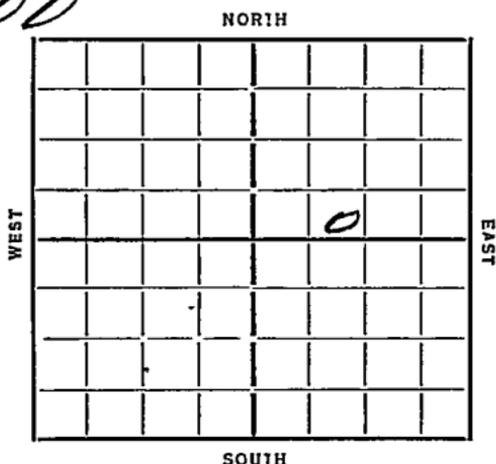

Date \_\_\_\_\_ REPORT

1935  
7/31 location  
8/8 BR  
8/15 Dlg 85 20" 93  
8/22 " 825 15" 326  
8/29 Aubey 885 10" 900  
" Dlg 2000  
9/6 " 2790 8" 2502  
10/2 Oswald 3023  
" 3281  
" 3288

70 A.

ABANDONED

Map No. 72 Sec. 14 Twp. 14 R. 15W

Well No. 1-Polypn

J. C. Shaffer Company

Contractor

FIRST REPORTS

SECTION PLAT

..... Ft. from N. Line

330 Ft. from S. Line

..... Ft. from E. Line

990 Ft. from W. Line

		0	

Location.....

Rig up.....

Drilling and Remarks:

RECORD

Cased..... in., ..... ft.

Sand.....

Gas.....

Oil.....

Total Depth.....

PRODUCTION

1st 24 hrs. Nat.....

1st 24 hrs. after shot.....

Gas..... Cu. Ft.

Dry Hole.....

Abandoned.....

Date

7-31-35 192

Scout

Map No. 72 Sec. 14 Twp. 14 R. 154

Well No. 1 - Polyn

J.C. Shaffer Company

Contractor

SECTION PLAT

		0	

..... Ft. from N. Line

330 Ft. from S. Line

..... Ft. from E. Line

990 Ft. from W. Line

**ABANDONED**

Location.....

Rig up.....

Drilling and Remarks.....

NO + A

RECORD

Cased..... in..... ft.

Sand Oswald 3023

Gas oil 3281

Oil.....

Total Depth 3288

PRODUCTION

1st 24 hrs. Nat.....

1st 24 hrs. after shot.....

Gas..... Cu. Ft.

Dry Hole.....

Abandoned.....

Date

10-2-35 192

ORVAL MANNSCHRECK

Scout