

Russell

KANSAS

Section 14 Township 14 Range 14-WWell No. #1 H. BoxbergerCompany Stanolind

NORTH

14

SOUTH

WEST

EAST

1939

1/11

7" = 2958'.

Lans. 2955'.

T. D. 3010'.

2000 acid.

Potential 679 bbls. ~~XXXX~~


Show of water.

COMPLETED

Russell **KANSAS**Map No. 72 Sec. 14 Twp. 14 R. 14WWell No. 1 H. BoxbergerStanolind


Company

Contractor

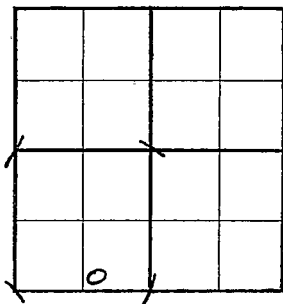FIRST REPORT**SW SE SW** Ft. from N. Line330 Ft. from S. Line990 Ft. from E. Line Ft. from W. Line**SECTION PLAT**Location XRig up Drilling and Remarks: **RECORD**Cased in., ft.Sand Gas Oil Total Depth **PRODUCTION**1st 24 hrs. Nat. 1st 24 hrs. after shot Gas Cu. Ft.Dry Hole Abandoned

Date

NOV 16 193819H. D. Hatfield Scout

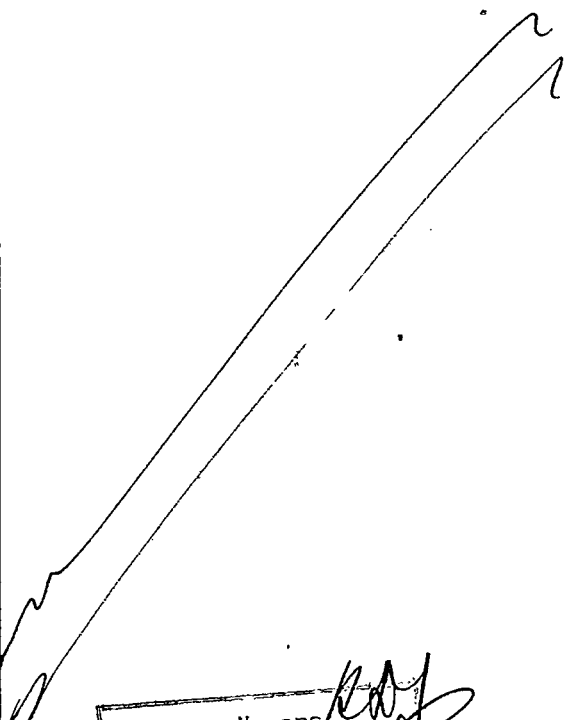


Russell

Map No. _____ Sec. 14 Twp. 14 R. 14WWell No. 1 H. BoxbergerStanolind

Company

Contractor

COMPLETED**SECTION PLAT'**

SW SE SW

_____ Ft. from N. Line

330 Ft. from S. Line990 Ft. from E. Line

_____ Ft. from W. Line

Gurney Lansing, Pool

Location _____

Rig up _____

Drilling and Remarks:

*2000 acid**Pot 679
S.W.***RECORD**Cased 7 in., 2958 ft.Sand LENS 2955

Gas _____

Oil _____

Total Depth 3010**PRODUCTION**

1st 24 hrs. Nat. _____

1st 24 hrs. after shot _____

Gas _____ Cu. Ft.

Dry Hole _____

Abandoned _____

Date

11 1938

19

H. D. Hatfield Scout

RMH
Misc Small Maps.....
Curry
Cards.....
Geo
Tracing.....
France Map.....
RMH
Scarborough Map.....
Moody Map.....
Geological Dept.
Moody Plat Book