


Section 14 Township 14 Range 14 W

Well No. # 2 Boxberger "B"

Company Fred Haynes

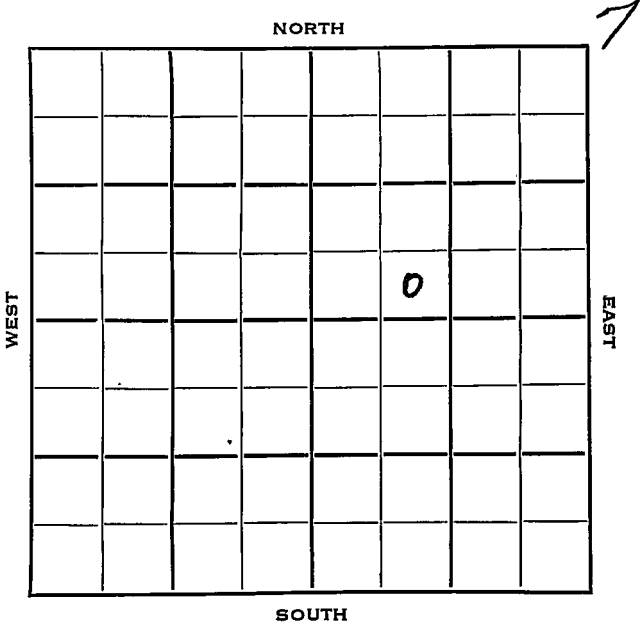

Russell

KANSAS

| | | |
|------------|------------|-----------|
| SEC. 14 | TWP. 14 | R. 11W |
|------------|------------|-----------|

WELL NO.

#2 Boxberger "B"₁₅

FARM

COMPANY

Fred Haynes

CONTRACTOR

Haynes

Hall-Gurney Pool NORTH

_____ Ft. from N. Line

330 _____ Ft. from S. Line

_____ Ft. from E. Line

990 _____ Ft. from W. Line

| | | | | | | | |
|--|--|--|--|--|---|--|--|
| | | | | | | | |
| | | | | | | | |
| | | | | | 0 | | |
| | | | | | | | |
| | | | | | | | |
| | | | | | | | |
| | | | | | | | |
| | | | | | | | |

SE SW NE

SOUTH

| | | |
|------|--------------------|--------|
| 1953 | ELEVATION 1826' | REPORT |
|------|--------------------|--------|

11/18

M I C T

12/16

Drlg.

1954

2/10

Spud 11-24-53

Oil well TD 3247 15" @ 320

12" @ 510 10" @ 810 Anhy 810

Tarkio 2390 8" @ 2425 Wab. 2555

Top. 2682 Heeb 2917 KC 2980

7" @ 2980 Arb. 3243' TD 3247

5" @ 3243 CO to 3247 FU 2200'

oil 14 hr.

Comp. 25 BOPD

COMPLETED

County Russell State Kansas

Sec. 14 (Blk.) 14 (Sur.) 14W Map No.

Operator Fred Haynes

Well No. 2 Farm Boxberger "B"

Elev. 1826 Location SE SW NE

| | | | | | | | | | |
|----------|--|--|--|--|--|--|--|--|--|
| COMPLETE | | | | | | | | | |
| | | | | | | | | | |
| | | | | | | | | | |
330 Ft. From S Line NE

990 Ft. From W Line Quarter

1st. Report

Completion FEB 10 1954

Remarks Hall-Gurney Pool
Haynes - Contr.

Spudding Date 11-24-53

Drig. Data Oil well TD 3247

15" @ 320 12" @ 510 10" @ 810

Anhy 810 Tarkio 2390 8" @ 2425

Wab. 2555 Top. 2682 Heeb. 2917

KC 2980 7" @ 2980 Arb. 3243

TD 3247 5" @ 3243 CO to 3247

FU 2200' oil 14 hr. Comp. 25 bopd

J. G. McGEHEE