

Section 14 Township 14 Range 14WWell No. #9 Boxberger "A"Company Fred Haynes

NORTH

9

WEST

EAST

						0	

SOUTH

Russell

KANSAS

SEC.	TWP.	R.
14	14	14W

WELL NO.

#9 Boxberger "A"

FARM

COMPANY

Fred Haynes

CONTRACTOR

Co. Tools.

330

Ft. from N. Line


Ft. from S. Line

990

Ft. from E. Line

Ft. from W. Line

NW NE SE

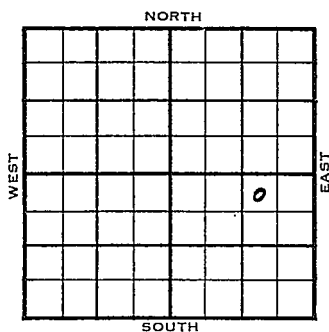

1954

ELEVATION

1821'

REPORT

12/15

Spud 12-11-54
Drilg. 375'

1955

1/26

Spud 12-11-54 - Oil Well

TD 3240'

10" @ 800'

Anhy 800', 1st Tarkio 2361', 2nd
Tarkio 2382'

8" @ 2415'

Top. 2685', Heeb. 2912', Lodge 2926',

KC 2973', Reagan sd 3235'

TD 3240'

5" @ 3235'

CO to 3240'


S/3 boph

Comp. 25 bopd

COMPLETED

FABEN G' STRAß

County Russell State Kansas
 Sec. 14 (Blk. 14 (Sur. 14W Map No. 14W)
 Operator Fred Haynes
 Well No. 9 Farm Boxberger "A"
 Elev. 1821 Location NW NE SE

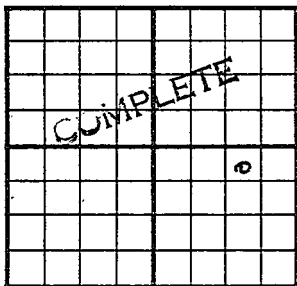

330 Ft. From N Line SE
990 Ft. From E Line Quarter
 Ist. Report
 Completion JAN 2 6 1955
 Remarks
Co. tools
 Spudding Date 12-11-54

Drlg. Data Oil well TD 3240
10" @ 800 Anhy 800 1st Tarkio 2361
2nd Tarkio 2382 8" @ 2415 Top. 2685
Heeb. 2912 Dodge 2926 KC 2973
Reagan sd. 3235 TD 3240 5" @ 3235
CO to 3240 S/ 3 boph Comp. 25 bopd

FABEN GILSTRAP