

Russell


KANSAS

FORM 51

Section 14 Township 14 Range 14W

Well No. #6 H. Boxberger

Company Texas Company

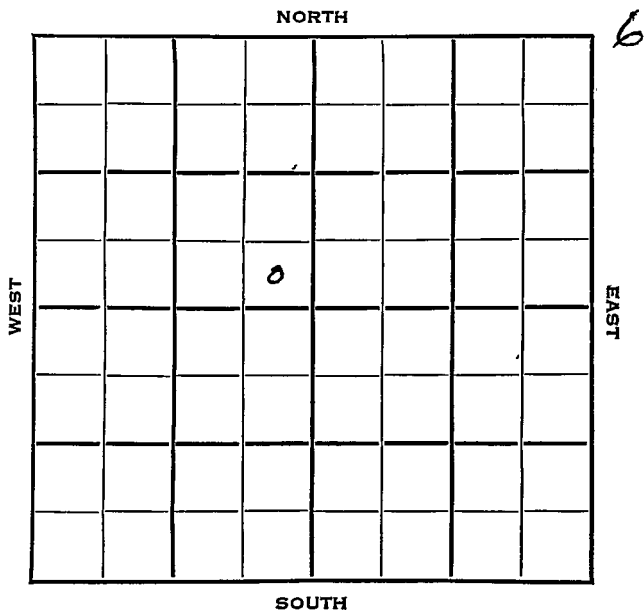

County **Russell** State **Kansas**

Sec. **14** (Blk. Twp.) **14** (Sur. Rge.) **14W** Map No.

Operator **Texas Company**

Well No. **6** Farm **H. Boxberger**

Elev. Location **SE SE NW**

FIRST REPORT					

330 Ft. From **S** Line **NW**

330 Ft. From **E** Line **Quarter**

1st. Report **FEB 10 1954**

Completion

Remarks

Spudding Date

Drlg. Data **Hall-Gurney Pool**

Location

