

KANSAS Russell


FORM 51 5M 4-41 PETROL

Section 14 Township 14 Range 15-W

Well No. ~~E~~ K. Polcyn #2

Company Transwestern

Gorham Pool

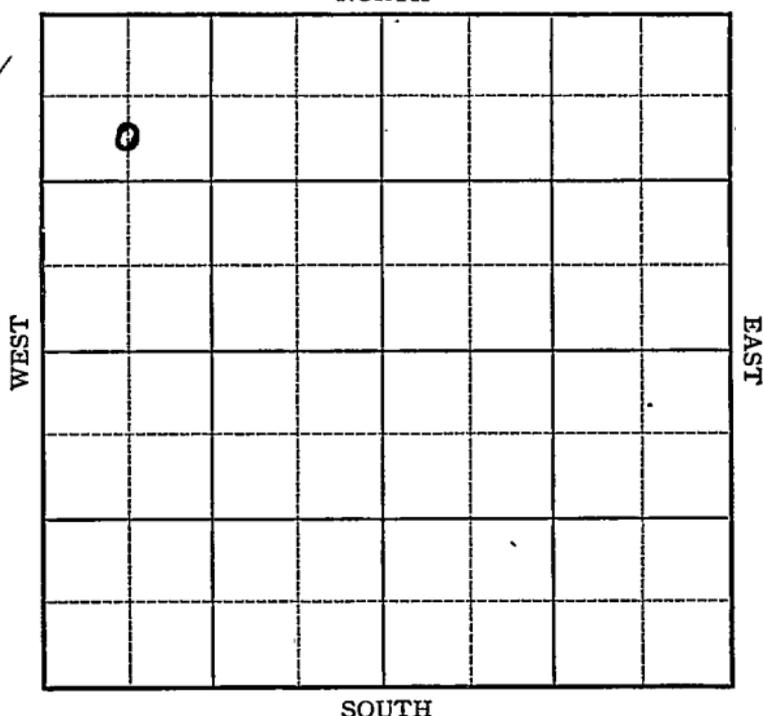

Sec. 14 Twp. 14 R. 15 -W

Well No. ~~#5~~ K. Polcyn #2 Farm

Transwestern Company

(Gorham)


990 Ft. from N. Line

_____ Ft. from S. Line

_____ Ft. from E. Line

660 Ft. from W. Line

Elev. 1813

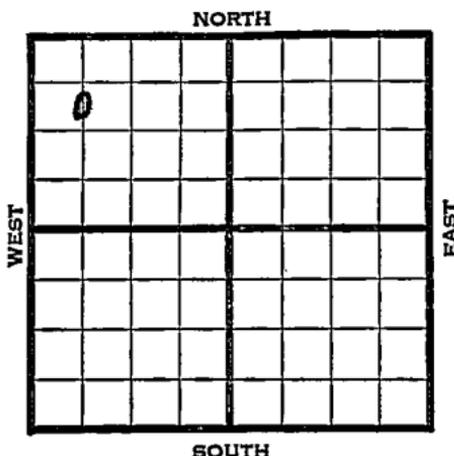

1941	REPORT
8/27	8" - 636'
	Anhy 845' Drlg. 1530'
9/4	Drlg. 3046'
9/11	Lans. 3000' Gorham 3222'
	5" - 3222' T.D. 3229' 2500'
	oil 9 hours.
9/17	Gorham 3222'
	5" - 3222'
	T.D. 3229'
	Potential 367 bbls., pump.
	36.5 Gravity
	COMPLETED

Map No. _____ Sec. 14 Twp. 14 R. 15W

Well No. 5 K. Polcyn

Transwestern Company

~~FIRST REPORT~~ Contractor

SECTION PLAT

990 C S L NW NW
Ft. from N. Line

_____ Ft. from S. Line

_____ Ft. from E. Line

660 Ft. from W. Line

o			

GORHAM POOL

Location _____

Rig up _____

Drilling and Remarks:

8" - 636

Anhy. 845

Drlg. 1530

RECORD

Cased _____ in., _____ ft.

Sand _____

Gas _____

Oil _____

Total Depth _____

PRODUCTION

1st 24 hrs. Nat. _____

1st 24 hrs. after shot _____

Gas _____ Cu. Ft.

Dry Hole _____

Abandoned _____

Date

AUG 27 1941

19

S. I. LEWIS

Scout

Map No. H-22 Sec. 14 Twp. 14 R. 15WWell No. 2 K PolcynTranswestern Company

Contractor

C SL NW NW

990 Ft. from N. Line

_____ Ft. from S. Line

_____ Ft. from E. Line

660 Ft. from W. Line

SECTION PLAT

o			

GORHAM POOL

RECORD

Location _____

Cased _____ in., _____ ft.

Rig up _____

Sand _____

Drilling and Remarks:

Gas _____

Completed Sept 17

Oil _____

1941

Total Depth _____

Changed from #5

to #2

PRODUCTION

1st 24 hrs. Nat. _____

1st 24 hrs. after shot _____

Gas _____ Cu. Ft.

Dry Hole _____

Abandoned _____

Date

OCT 15 1941 19S. J. LEWIS Scout

Russell

Map No. _____ Sec. 14 Twp. 14 R. 15W

Well No. 5 K. Polcyn

Transwestern Company

~~COMPLETED~~ Contractor

SECTION PLAT

C S L SW NW

0			

990 Ft. from N. Line

_____ Ft. from S. Line

_____ Ft. from E. Line

660 Ft. from W. Line

GORHAM POOL

Location _____

Rig up _____

Drilling and Remarks:

For lam 3222

5" @ 3222

Pump 367 ft

365 ft

RECORD

Cased _____ in., _____ ft.

Sand _____

Gas _____

Oil _____

Total Depth 3229

PRODUCTION

1st 24 hrs. Nat. _____

1st 24 hrs. after shot _____

Gas _____ Cu. Ft.

Dry Hole _____

Abandoned _____

Date

SEP 17 1941 19

S. J. LEWIS Scout