
Form 51-5M 5-37 Petrol

Russell County Kansas

Section 14 Township 14 Range 15W

Well No. #4 K. Palcyn

Company Transwestern

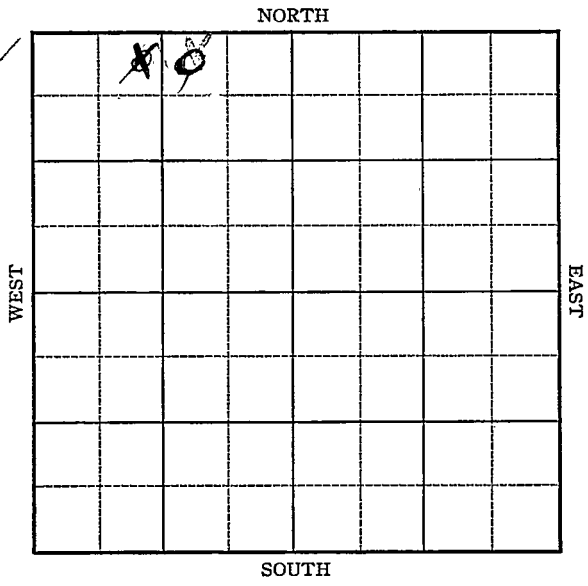

Form 252-A—5M—2-37—Palace KANSAS Russell

Sec. 14 Twp. 14 R. 15-W

Well No. ~~#3~~ K. Polcyn #4 Farm


Transwestern Company

330 Ft. from N. Line

Ft. from S. Line

990 Ft. from E. Line

Ft. from W. Line

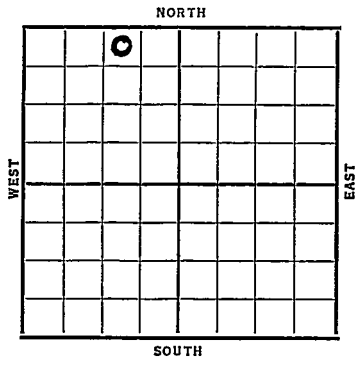

Date	REPORT
1937	
7/28	R. U. R.
8/6	10" @ 610'. Drlg. 1700'.
8/13	Drlg. 2730'.
8/20	7" @ 3236'. WOC.
8/25	8" @ 3236'
	Gorham 3250'
	TD 3250'
	228/4
	208/4
	Pot 1248'
	COMPLETED

Form 26—1M/Bks—2-29

KANSAS Russell

Map No. _____ Sec. 14 Twp. 14 R. 15 W

Well No. 5- K. Palczyn

Transwestern Company

_____ Contractor

FIRST REPORT


330 Ft. from N. Line

_____ Ft. from S. Line

990 Ft. from E. Line

_____ Ft. from W. Line

SECTION PLAT

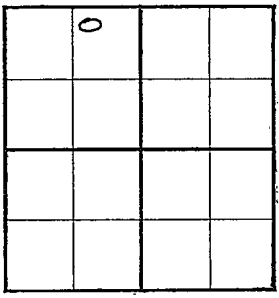

Location _____

Rig up _____

Drilling and Remarks:

R. U. R.

RECORD

Cased _____ in., _____ ft.

Sand _____

Gas _____

Oil _____

Total Depth _____

PRODUCTION

1st 24 hrs. Nat. _____

1st 24 hrs. after shot _____

Gas _____ Cu. Ft.

Dry Hole _____

Abandoned _____

Date

JUL 28 1953/19

H. D. Hatfield Scout

Form 26—1M Bks.—2-29 Russell KANSAS

Map No. _____ Sec. 14 Twp. 14 R. 15W

Well No. 3-K. Polcyn

Transwestern Company

_____ Contractor

CORRECTION


330 Ft. from N. Line

_____ Ft. from S. Line

_____ Ft. from E. Line

990 Ft. from W. Line

SECTION PLAT

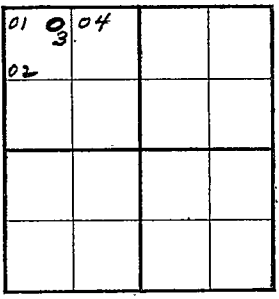

Location _____

Rig up _____

Drilling and Remarks:

This well was originally carried as #3 and AFTER #2 Loc was Abd The NO. OF This well was changed TO #2. Now IT is changed back To #3

RECORD

Cased _____ in., _____ ft.

Sand _____

Gas _____

Oil _____

Total Depth _____

PRODUCTION

1st 24 hrs. Nat. _____

1st 24 hrs. after shot _____

Gas _____ Cu. Ft.

Dry Hole _____

Abandoned _____

Date

AUG 25 1937 19

H. D. Hatfield Scout

Form 26—1M Bks.—2-29 Russell KANSAS

Map No. Sec. 14 Twp. 14 R. 15 W (see correction ticket)

Well No. 4-K Polcyn

Transwestern Company

Contractor

COMPLETED


330 Ft. from N. Line

Ft. from S. Line

990 Ft. from E. Line

Ft. from W. Line

SECTION PLAT

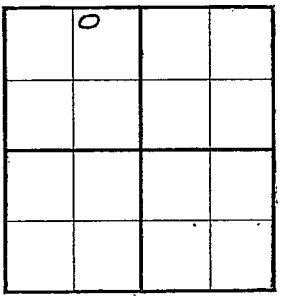

Location

Rig up

Drilling and Remarks:

228/4

208/4

Pot-1248

RECORD

Cased 7 in., 3236 ft.

Sand Gorham 3247

Gas

Oil

Total Depth 3250

PRODUCTION

1st 24 hrs. Nat.

1st 24 hrs. after shot

Gas Cu. Ft.

Dry Hole

Abandoned

Date

AUG 25 1937 19

H. D. Hatfield Scout

Form 26—1M Bks.—2-29

Russell KANSAS

Map No. _____ Sec. 14 Twp. 14 R. 15-W

Well No. 4 - K. Poleyn


Transwestern Company

_____ Contractor

Completed well This week

CORRECTION

SECTION PLAT

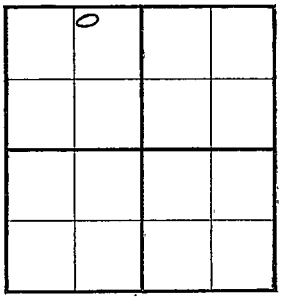

330 Ft. from N. Line

_____ Ft. from S. Line

990 Ft. from E. Line

_____ Ft. from W. Line

Location _____

Rig up _____

Drilling and Remarks:

first reported as #3 but has been changed to #4

RECORD

Cased _____ in., _____ ft.

Sand _____

Gas _____

Oil _____

Total Depth _____

PRODUCTION

1st 24 hrs. Nat. _____

1st 24 hrs. after shot _____

Gas _____ Cu. Ft.

Dry Hole _____

Abandoned _____

Date

AUG 25 1937 19____

H. D. Hatfield Scout