

Section 14 Township 14 Range 15-W

Well No. #2 Smith

Company Murfin Drlg.

NORTH

SOUTH

C

Sec. 14 Twp. 14 R. 15W ✓

Well No. #2 Smith Farm

Murfin Drlg. Company

Contractor

Big Creek


Ft. from N. Line

990' Ft. from S. Line

990' Ft. from E. Line

Ft. from W. Line

NW SE SW

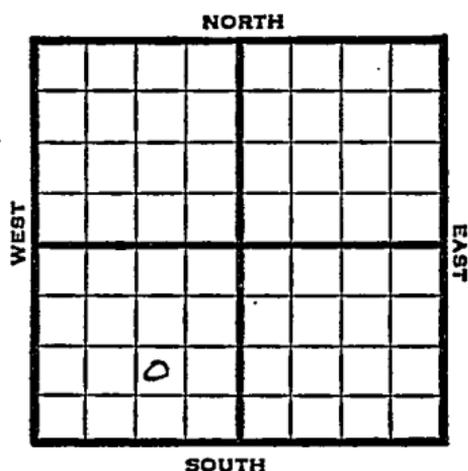

1950 Elev1805 REPORT

5/24 Spud 5-21-50
8" @ 517'
WOC

7/5 TD 3260
8" @ 517
Anhy 845
Lans 2981
Arb 3226
5" @ 3248
TD 3260
FU 3200' oil 8 hr
Comp 75 bopd
Completed

Heeb 2928
Gorham 3220
Regan 3258-60

COMPLETED

Map No. _____ Sec. 14 Twp. 14 R. 15WWell No. 2 SmithMurfin Drlg. Company

Contractor

NW SE SW

SECTION PLAT

_____ Ft. from N. Line

990 Ft. from S. Line990 Ft. from E. Line

_____ Ft. from W. Line

FIRST	REPORT		
	o		

Russell

Location _____

Rig up _____

Drilling and Remarks:

Spud 5-21-50

8" @ 517

W. O. C.

RECORD

Cased _____ in., _____ ft.

Sand _____

Gas _____

Oil _____

Total Depth _____

PRODUCTION

✓ 1st 24 hrs. Nat. _____

✓ 1st 24 hrs. after shot _____

Gas _____ Cu. Ft.

Dry Hole _____

Abandoned _____

Date

MAY 24 1950

19

J. E. TYRA Scout

Kansas

Map No. _____ Sec. 14 Twp. 14 R. 15WWell No. 2 Smith

_____ Murfin Drlg. _____ Company

_____ Contractor


NW SE SW

E1. 1805
SECTION PLAT

_____ Ft. from N. Line

990 Ft. from S. Line990 Ft. from E. Line

_____ Ft. from W. Line

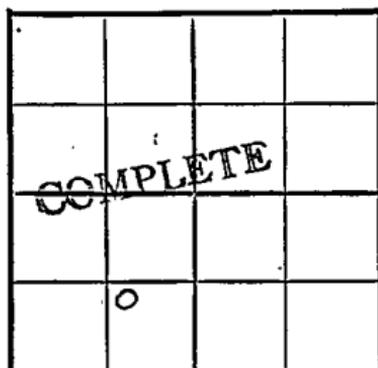

Russell County

Location _____

Rig up _____

Drilling and Remarks:

8" C 517

Anhy 845

Heeb. 2928

Lans. 2981

Gorham 3220

Arb. 3226

Regan 3258-60

RECORD

Cased _____ in., _____ ft.

Sand _____

Gas _____

Oil _____

Total Depth 3260

PRODUCTION

1st 24 hrs. Nat. _____

1st 24 hrs. after shot _____

Gas _____ Cu. Ft.

Dry Hole _____

Abandoned _____

Date

JUL 5 1950 19J. E. TYRA Scout