Form 51-5M-12-36 Com'l

KANSAS


Russell

Section #14 Township 14 Range 15W

Well Number #8 #5 K. Poleyn #3

(Polcyn)

Company Transwestern

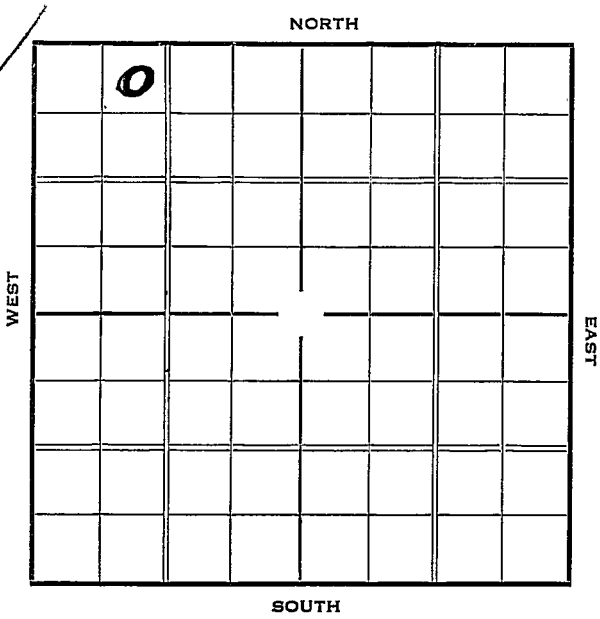

Form 252-A—5M—2-37—Palace KANSAS Russell

Sec. 14 Twp. 14 R. 15-W

Well No. ~~#2~~ K. Polcyn #3 Farm


TransWestern Company

330' Ft. from N. Line

Ft. from S. Line

Ft. from E. Line

990' Ft. from W. Line

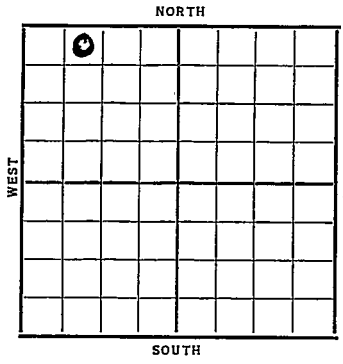

Date	REPORT
1937	
7/7	Material
7/16	10" @ 608'. WOC.
7/23	Drlg. 2295'.
7/30	7" @ 3219'. RUST.
8/6	Gorham 3232'. T.D. 3235'. Testing.
8/11	7" @ 3219'.
	Gorham 3232'.
	T.D. 3235'.
	Pot. 1333 bbls.
	COMPLETED

Form 26—1M Bks.—2-29 Russell KANSAS

Map No. Sec. 14 Twp. 14 R. 15-W

Well No. 3 - K. Paleyn

Transwestern Company

Contractor

FIRST REPORT


3330 Ft. from N. Line

Ft. from S. Line

Ft. from E. Line

990 Ft. from W. Line

SECTION PLAT

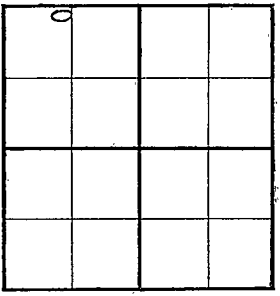

Location

Rig up

Drilling and Remarks:

Material

RECORD

Cased in., ft.

Sand

Gas

Oil

Total Depth

PRODUCTION

1st 24 hrs. Nat.

1st 24 hrs. after shot

Gas Cu. Ft.

Dry Hole

Abandoned

Date

JUL 7 1937 19 H. D. Hatfield Scout

Form 26—1M Bks.—2-29

Russell KANSAS

Map No. _____ Sec. 14 Twp. 14 R. 15W

Well No. #2 Katherina Polyn

Transwestern Company

_____ Contractor

CORRECTION


330 Ft. from N. Line

_____ Ft. from S. Line

_____ Ft. from E. Line

990 Ft. from W. Line

SECTION PLAT

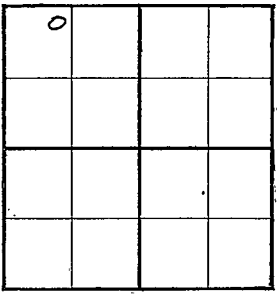

Location _____

Rig up _____

Drilling and Remarks:

Number changed From #3.

original #2 has been Abd.

RECORD

Cased _____ in., _____ ft.

Sand _____

Gas _____

Oil _____

Total Depth _____

PRODUCTION

1st 24 hrs. Nat _____

1st 24 hrs. after shot _____

Gas _____ Cu. Ft.

Dry Hole _____

Abandoned _____

Date

JUL 28 1937 19 H. D. Hatfield Scout

Form 26—1M Bks.—2-29 Russell KANSAS

Map No. _____ Sec. 14 Twp. 14 R. 15-W

Well No. 2-K. Polcyn

Transwestern Company

_____ Contractor

COMPLETED


330 Ft. from N. Line

_____ Ft. from S. Line

_____ Ft. from E. Line

990 Ft. from W. Line

SECTION PLAT

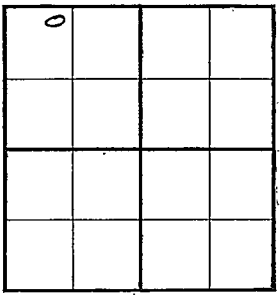

Location _____

Rig up _____

Drilling and Remarks:

Pot 1333

RECORD

Cased 7 in., 3219 ft.

Sand Gorham 3232

Gas _____

Oil _____

Total Depth 3235

PRODUCTION

1st 24 hrs. Nat. _____

1st 24 hrs. after shot _____

Gas _____ Cu. Ft.

Dry Hole _____

Abandoned _____

Date

AUG 11 1937 19

H. D. Hatfield Scout