

Russell

KANSAS

Sec. 14 Twp. 14 R. 15W

Well No. #1 W. J. Smith Farm

Finston & Murfin Company


Gorham Pool

 Ft. from N. Line

330' Ft. from S. Line

330' Ft. from E. Line

 Ft. from W. Line

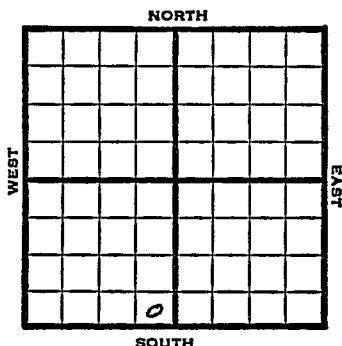

SE SE SW

1950

REPORT

1/11

Location

1/18

Location

Aband.

ABANDONED

ans29

Map No. _____ Sec. 14 Twp. 14 R. 15WWell No. 1 W. J. SmithFinston & Murfin Company

Contractor

SE SE SW

SECTION PLAT

_____ Ft. from N. Line

330 Ft. from S. Line330 Ft. from E. Line

_____ Ft. from W. Line

Russell County

Location X

Rig up _____

Drilling and Remarks:

RECORD

Cased _____ in., _____ ft.

Sand _____

Gas _____

Oil _____

Total Depth _____

PRODUCTION

1st 24 hrs. Nat. _____

1st 24 hrs. after shot _____

Gas _____ Cu. Ft.

Dry Hole _____

Abandoned _____

Date

JAN 11 1950

19

J. E. TYRA

Scout


Map No. _____ Sec. 14 Twp. 14 R. 15WWell No. 1 W. J. Smith

_____ Finston & Murfin _____ Company

_____ Contractor

SE SE SW

SECTION PLAT

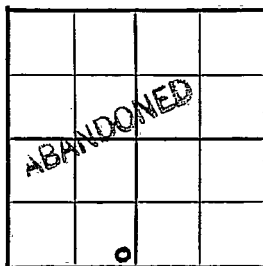

_____ Ft. from N. Line

330 Ft. from S. Line330 Ft. from E. Line

_____ Ft. from W. Line

Russell County

Location _____

Rig up _____

Drilling and Remarks:

*Location
Abandoned*

RECORD

Cased _____ in., _____ ft.

Sand _____

Gas _____

Oil _____

Total Depth _____

PRODUCTION

1st 24 hrs. Nat. _____

1st 24 hrs. after shot _____

Gas _____ Cu. Ft.

Dry Hole _____

Abandoned _____

Date

J. E. TYRA

JAN 18 1950 19

Scout