


Section 15 Township 14 Range 29W

Well No. #2 Coberly

Company Cities Service

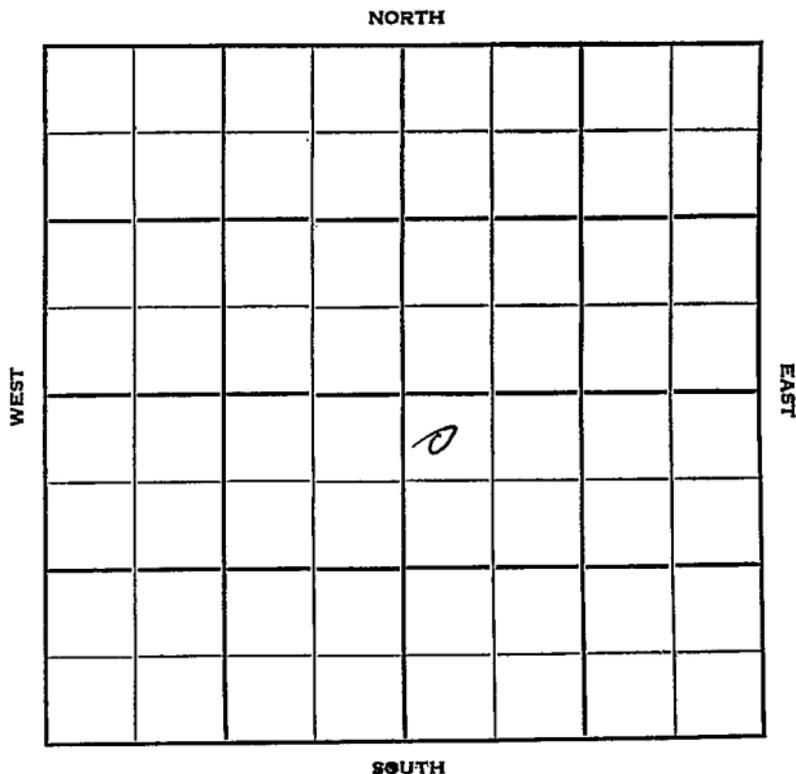

Sec. 15 Twp. 14 R. 29 W ✓

Well No. # 2 Coberly Farm

Cities Service Company

Lohman & Johnson Contractor


**Coberly Pool**

330 Ft. from N. Line

\_\_\_\_\_ Ft. from S. Line

\_\_\_\_\_ Ft. from E. Line

330 Ft. from W. Line

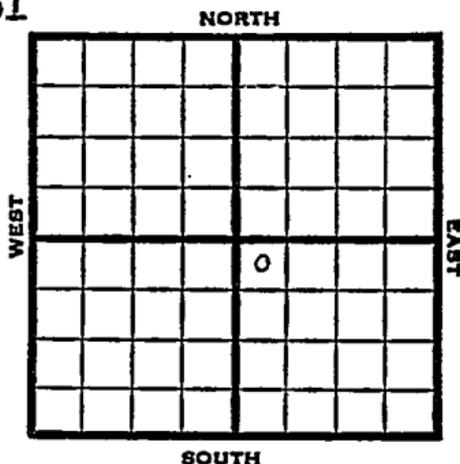

NW NW SE

1951

Elev. 2616'

REPORT

5/23  
7/3

Location

Spud 5-26-51

Oil well TD 4360' 8" @ 240'

Top. 3451' Heeb 3674' Dodge 3696'

Lans. 3714' B KC 4025' Mar 4044'

DST 4220-4302 open 36 min. rec 405' mud

DST 4302-10 open 1 hr. rec 160' oil, 60

mud & oil Miss 4345' TD 4360'

5" @ 4360' 29/4304-11 FU 710' oil

1 1/4 hr. 500 A

Comp. 346 BOPD 4% water

**COMPLETED**



