


Section 15 Township 14 Range 29WWell No. #3 CaberlyCompany Cities Service Oil

NORTH

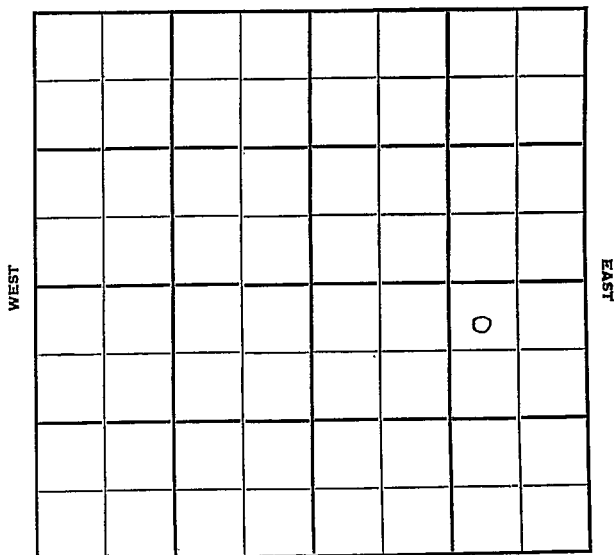

SOUTH

Gove

KANSAS

Sec. 15 Twp. 14 R. 29W

Well No. #3 Caberly Farm

Cities Service Oil Company

Caberly Pool Contractor


330' Ft. from N. Line

Ft. from S. Line

990' Ft. from E. Line

Ft. from W. Line

NW NE SE

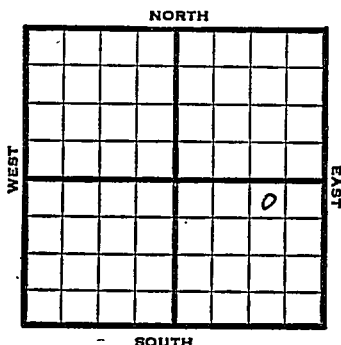

1951

Elev. 2648' REPORT

9/12

Location

10/10

Spud 9-11-51

D&A TD 4454

8" @ 200

Dodge 3734 Lans. 3751

DST 3837-67 opn 1 hr Rec. 625' sw

BKC 4062

DST 4230-11 opn 1 hr

Rec. 30' mud

Ch. Cong. 4359 Miss 4387

TD 4454 D&A

ABANDONED

County Gove State KansasSec. 15 (^{Blk.}_{Twp.}) 14 (^{Sur.}_{Rge.}) 29W Map No.Operator Cities Service OilWell No. 3 Farm CaberlyElev. _____ Location NW NE SE

FIRST REPORT

330 Ft. From N Line SE990 Ft. From E Line Quarter1st. Report SEP 12 1951

Completion _____

Remarks _____

Spudding Date _____

Caberly - pool

Drlg. Data _____

Location

J. E. TYRA

County Gove State Kansas

Sec. 15 (Blk. Twp.) 14 (Sur. Rge.) 29W Map No.

Operator	Cities Service
----------	----------------

Well No. 3 Farm Coberly

Elev.	2648	Location	NW NE SE
-------	------	----------	----------

330 Ft. From N Line SE

990 Ft. From E Line Quarter

1st. Report _____

Completion OCT 10 1951

Remarks Coberly Pool

Spudding Date 9-11-51

Drig. Data D & A TD 4454

8" @ 200 Dodge 3734 Lans. 3751

DST 3837-67 open 1 hr. Rec. 625' sw

B KC 4062 DST 4230-11 open 1 hr.

Rec. 30' mud Ch. Cong. 4359 Miss. 4387

TD 4454 D & A

J. E. TYRA