


Map No. KANSAS Sec. 15 Twp. 14 R. 16^w
 Well No. 1- Robbins Farm
Rob Johnson Company
T.C. Johnson NORTH

..... Ft. from N. Line

330 Ft. from S. Line

..... Ft. from E. Line

330 Ft. from W. Line

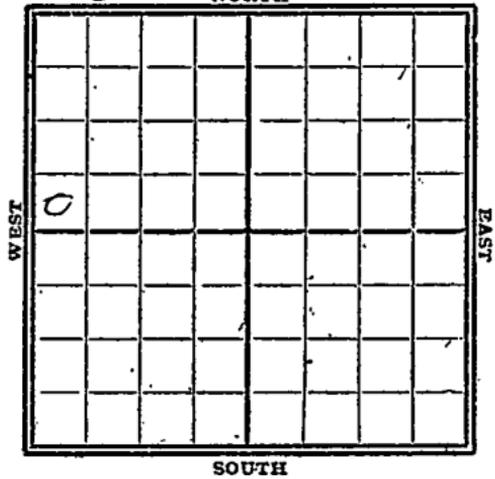

1928

Date.

REPORT

12/12

Location

12/19

12/26

Rig

1929

1/2

1/9

Rig up

1/16

1/23

1/30

2/6

2/13

2/20

Rig d. up & S.D.

2/27

3/6

3/13

3/20

3/27

U/R 15"-560'-T.D.

4/3

Drly. 1021'

4/10

Rig burned

4/17

ReBldg Rig

4/24

Rig d. up

5/1

5/8 - well 1625'
5/14 - " 2065'
5/22 - U.P. 8" - 2630'
5/29 - Cement Cave 2900'
6/5 - _____
6/12 - well 2940
6/19 - well 3240 6" - 3204'
6/26 - " 3350'
7/2 - 5" - 3468 H.F. at 3478
shut down.
7/9 - _____
7/17 - T.D. 3502'
Dry & Abandon

Edwards
NO MAP
 Map No. **KANSAS** Sec. 15 Twp. 14 R. 16XX

Well No. 1 Rottens

B. O. Ostry et al Company

Contractor

SECTION PLAT

0			

..... Ft. from N. Line

330 Ft. from S. Line

..... Ft. from E. Line

330 Ft. from W. Line

FIRST REPORTS

Location ✓

Rig up

Drilling and Remarks:

RECORD

Cased..... in., ft.

Sand

Gas

Oil

Total Depth.....

PRODUCTION

1st 24 hrs. Nat.....

1st 24 hrs. after shot.....

Gas..... Cu. Ft.

Dry Hole.....

Abandoned.....

Date

DEC 12 1928

S. J. LEWIS

Scout

no wall map

Returned
Cards	<i>Three</i>
Tracing	<i>No map</i>
France Map
Scarborough Map
Moody Map
Scarborough Plat Book
Moody Plat Book

Map No. KANSAS Sec. 15 Twp. 14 R. 16 W
 Well No. 1 R. & Hens.

J. C. Johnson. Company
 Contractor

SECTION PLAT

..... Ft. from N. Line
330 Ft. from S. Line
 Ft. from E. Line
390 Ft. from W. Line

CORRECTION

Location.....

Rig up.....

Drilling and Remarks:

*Johnson has
 taken this over
 from O. S. J.*

RECORD

Cased..... in., ft.
 Sand.....
 Gas.....
 Oil.....
 Total Depth.....

PRODUCTION

1st 24 hrs. Nat.....
 1st 24 hrs. after shot.....
 Gas..... Cu. Ft.
 Dry Hole.....
 Abandoned.....

Date

APR 10 1929

S. J. LEWIS

Scout


map

Returns
Cards	<i>Ches</i>
Tracing	<i>map</i>
France Map
Scarborough Map
Moody Map
Scarborough Plat Book
Moody Plat Book

Map No. KANSAS Sec. 15 Twp. 14 R. 16 W

Well No. 1 Roy Henry

T. C. Johnson Company

Contractor

SECTION PLAT

0			

..... Ft. from N. Line

330 Ft. from S. Line

..... Ft. from E. Line

330 Ft. from W. Line

ABANDONED

Location.....

Rig up.....

Drilling and Remarks:

RECORD

Cased..... in., ft.

Sand.....

Gas.....

Oil.....

Total Depth 3502

PRODUCTION

1st 24 hrs. Nat.....

1st 24 hrs. after shot.....

Gas..... Cu. Ft.

Dry Hole.....

Abandoned.....

Date

JUL 17 1929 92

S. J. LEWIS Scout

Mr. Wainwright

Wainwright

Returned	<i>Tab</i>
Cards	
Tracing	<i>OK</i>
France Map	<i>Done</i>
Scarborough Map	
Moody Map	
Scarborough Plat Book	
Moody Plat Bco'	