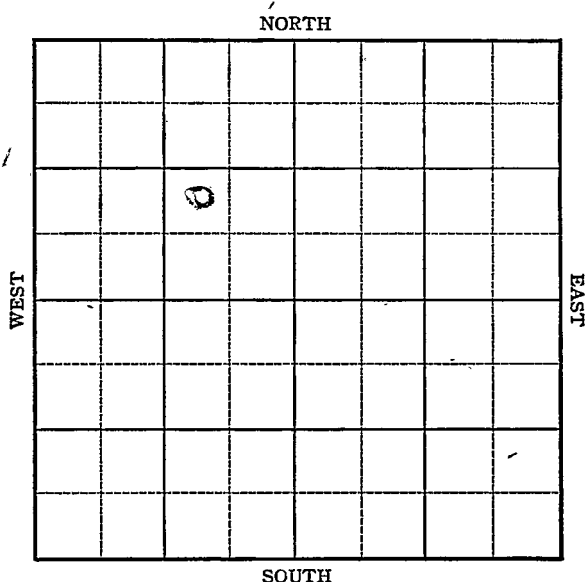


Section 15 Township 14 Range 15WWell No. #8, RoubackCompany Co-op

KANSAS

Russell County

Sec. 15 Twp. 14 R. 15W

Well No. #8 Rouback Farm \_\_\_\_\_

Co-op \_\_\_\_\_ Company \_\_\_\_\_

Big Creek

\_\_\_\_\_ Ft. from N. Line

990 Ft. from S. Line


990

660 Ft. from E. Line

\_\_\_\_\_ Ft. from W. Line

NW

CNE SE NW

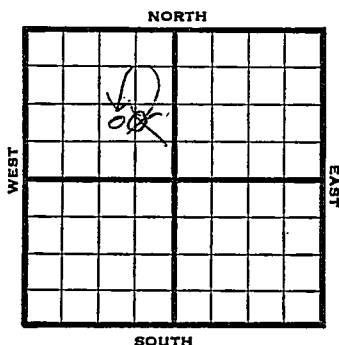

1946

Elev. 1818

R E P O R T

5/8

Location

5/14

Abhy 863  
8" @ 873 WOC

5/21

Dr1g 2800'

5/29

Gorham 3225  
TD 3233

6/5

5" @ 3225' RUST  
2200' oil 2 hrs.

6/12

" " "

6/18

" " "

6/26

" " "

7/3

Gorham 3225  
5" @ 3225  
TD 3233'  
Pump 33 oil plus 94% W. Pot.  
Grav. 34.0

COMPLETED

**KANSAS**Kansas Pool Name Big CreekMap No. \_\_\_\_\_ Sec. 15 Twp. 14 R. 15WWell No. 8 Rouback

\_\_\_\_\_ Co-Op \_\_\_\_\_ Company

\_\_\_\_\_ **FIRST REPORT** \_\_\_\_\_ ContractorC N L SE NW**SECTION PLAT**

|  |   |  |  |
|--|---|--|--|
|  |   |  |  |
|  | o |  |  |
|  |   |  |  |
|  |   |  |  |

\_\_\_\_\_ Ft. from N. Line

990 Ft. from S. Line660 Ft. from E. Line

\_\_\_\_\_ Ft. from W. Line

Russell County

Location \_\_\_\_\_

Rig up \_\_\_\_\_

Drilling and Remarks:

**RECORD**

Cased \_\_\_\_\_ in., \_\_\_\_\_ ft.

Sand \_\_\_\_\_

Gas \_\_\_\_\_

Oil \_\_\_\_\_

Total Depth \_\_\_\_\_

**PRODUCTION**

1st 24 hrs. Nat. \_\_\_\_\_

1st 24 hrs. after shot \_\_\_\_\_

Gas \_\_\_\_\_ Cu. Ft.

Dry Hole \_\_\_\_\_

Abandoned \_\_\_\_\_

Date

MAY 8 1946 19S. J. LEWIS Scout

**KANSAS**Pool Name Big CreekMap No. 72 Sec. 15 Twp. 14 R. 15WWell No. 8 Rouback

Co-op \_\_\_\_\_

Company \_\_\_\_\_

**CORRECTION**

Contractor \_\_\_\_\_

NW SE NW

**SECTION PLAT**

|  |   |  |  |
|--|---|--|--|
|  |   |  |  |
|  | o |  |  |
|  |   |  |  |
|  |   |  |  |
|  |   |  |  |

\_\_\_\_\_ Ft. from N. Line

990 Ft. from S. Line990 Ft. from E. Line

\_\_\_\_\_ Ft. from W. Line

**Russell County**

Location \_\_\_\_\_

Rig up \_\_\_\_\_

Drilling and Remarks:

Reported

C N L SE NW

**RECORD**

Cased \_\_\_\_\_ in., \_\_\_\_\_ ft.

Sand \_\_\_\_\_

Gas \_\_\_\_\_

Oil \_\_\_\_\_

Total Depth \_\_\_\_\_

**PRODUCTION**

1st 24 hrs. Nat. \_\_\_\_\_

1st 24 hrs. after shot \_\_\_\_\_

Gas \_\_\_\_\_ Cu. Ft.

Dry Hole \_\_\_\_\_

Abandoned \_\_\_\_\_

Date

**MAY 15 1946** 19**S. J. LEWIS** Scout

KANSAS

Kansas Pool Name Big Creek PoolMap No. 72 Sec. 15 Twp. 14 R. 15WWell No. 8 Rouback

Co-op

Company

COMPLETED

Contractor

NW SE NW

*E. 1. 1879.*  
SECTION PLAT

|  |   |  |  |
|--|---|--|--|
|  |   |  |  |
|  | o |  |  |
|  |   |  |  |
|  |   |  |  |
|  |   |  |  |

Ft. from N. Line

990 Ft. from S. Line990 Ft. from E. Line

Ft. from W. Line

Russell County

Location

Rig up

Drilling and Remarks:

*Grham 3225**5" @ 3225**Pump 33 oil + 94%*  
*W. P. Y.**34 2/3*

## RECORD

Cased \_\_\_\_\_ in., \_\_\_\_\_ ft.

Sand \_\_\_\_\_

Gas \_\_\_\_\_

Oil \_\_\_\_\_

Total Depth 3253

## PRODUCTION

1st 24 hrs. Nat. \_\_\_\_\_

1st 24 hrs. after shot \_\_\_\_\_

Gas \_\_\_\_\_ Cu. Ft.

Dry Hole \_\_\_\_\_

Abandoned \_\_\_\_\_

Date

JUL 3 1946

19

S. J. LEWIS

Scout