

Russell

KANSAS


Form 51-5M 5-37 Petrol

Section 15 Township 14 Range 15-W

Well No. 1 Rouback

Company Wolf Creek

NORTH

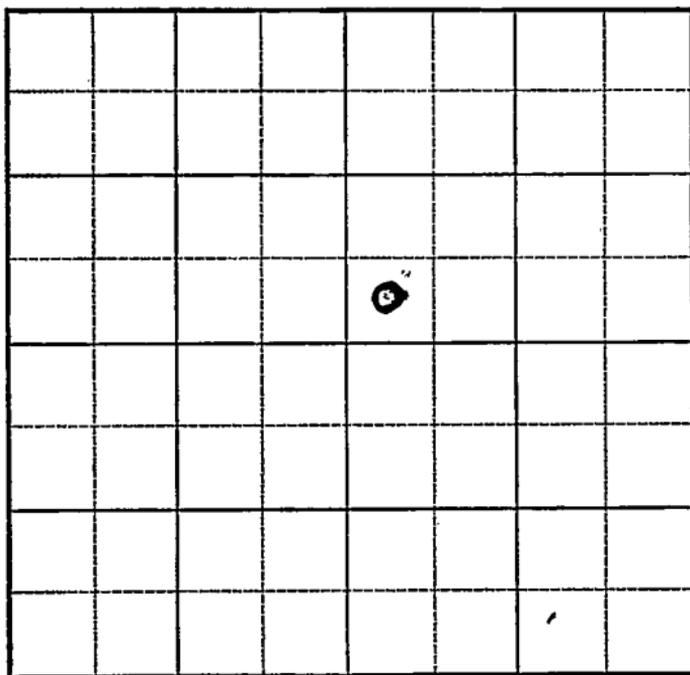

SOUTH



Sec. 15 Twp. 14 R. 15-W

Well No. #1 Rouback Farm

Wolf Creek Company


Ft. from N. Line

330 Ft. from S. Line

Ft. from E. Line

330 Ft. from W. Line

Elev. 1798

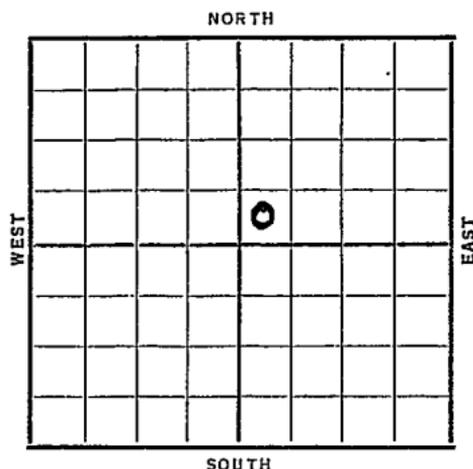

Date

REPORT

1937

12/15 Drlg. 280'.

12/24 12" @ 485'. Anhy 837'.

10" @ 846'. Drlg. 1825'.

12/31 8" @ 2305'. Drlg. 2350'.

1938

1/7 8" @ 2415'. Drlg. 2760'.

1/14 Lans. 2971'. S.O. 2998-3002'.

6" @ 2998'. S.O. 3031-34'.

2 B.W. 3050-58'. Drlg. 3130'.

1/20 Gorham 3206' T.D. 3210'

1800' oil 1 hr. Swb 50 bbls

oil P.H. gravity 34 @ 55

1/28 5" - 3200' on Pot.

2/2 5" @ 3200'.

Gorham 3206'.

T.D. 3210'.

Potential 2259 bbls.

COMPLETED

Russell **KANSAS**

Map No. 72 Sec. 15 Twp. 14 R. 15W

Well No. 1 Rouback

Wolf Creek Company

Contractor

FIRST REPORT

SECTION PLAT

SW NE

_____ Ft. from N. Line

330 Ft. from S. Line

_____ Ft. from E. Line

330 Ft. from W. Line

		0	

Location _____

Rig up _____

Drilling and Remarks:

Drlg. 280

RECORD

Cased _____ in., _____ ft.

Sand _____

Gas _____

Oil _____

Total Depth _____

PRODUCTION

1st 24 hrs. Nat. _____

1st 24 hrs. after shot _____

Gas _____ Cu. Ft.

Dry Hole _____

Abandoned _____

Date

DEC 15 1937

19

H. D. Hatfield Scout

Map No. _____ Sec. 15 Twp. 14 R. 15 W

Well No. 1 Rouback

Wolf Creek Company

Contractor _____

COMPLETED

SW NE

_____ Ft. from N. Line

330 Ft. from S. Line

_____ Ft. from E. Line

330 Ft. from W. Line

SECTION PLAT

		0	

Location _____

Rig up _____

Drilling and Remarks:

POT - 2259

RECORD

Cased 5 in., 3200 ft.

Sand Gorham 3206

Gas _____

Oil _____

Total Depth 3210

PRODUCTION

1st 24 hrs. Nat. _____

1st 24 hrs. after shot _____

Gas _____ Cu. Ft.

Dry Hole _____

Abandoned _____

Date

FEB 2 1938 19 _____ P. D. Hatfield Scout