


Section 15 Township 14 Range 15-W

Well No. 2 Rouback "A"

Company Wolf Creek

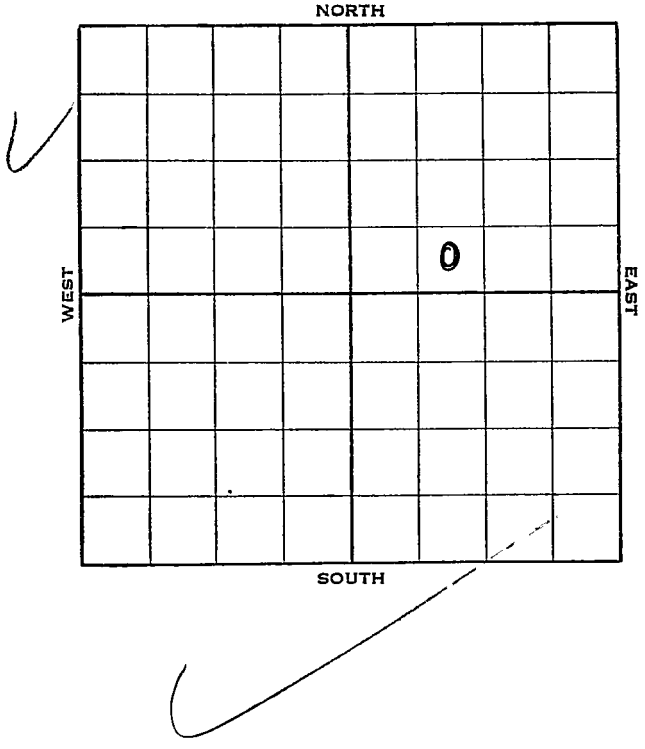

Sec. 15 Twp. 14 R. 15-W


Well No. #2 Roubach "A" Farm
Wolf Creek Company

_____ Ft. from N. Line

330 Ft. from S. Line

_____ Ft. from E. Line

990 Ft. from W. Line

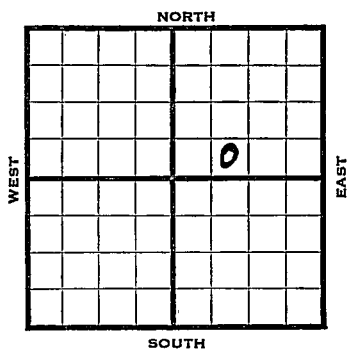

Elev. 1800

1938	REPORT
8/31	15" - 292'. 12" - 485'. Anhy. 834'. Rng. 10".
9/9	10" - 837'. Dlg. 1750'.
9/16	Dlg. 2435'.
9/23	8" - 2519'. Dlg. 2655'.
9/30	Lans. 2970'. S. O. 3065-70'. 7" - 3145'. Dlg. 3165'.
10/7	Gorham 3216-19' T.D. 2900' oil 3 hrs. 7" - 3213'. WOC.
10/12	7" - 3213'. Gorham 3216'. T. D. 3219'. Potential 510 bbls.
	COMPLETED

Map No. 72 Sec. 15 Twp. 14 R. 15W

Well No. 2 Roubach "A"

Wolf Creek

Company _____

Contractor _____

FIRST REPORT

SE SW NE

_____ Ft. from N. Line

330 Ft. from S. Line

_____ Ft. from E. Line

990 Ft. from W. Line

SECTION PLAT

		0	

Location _____

Rig up _____

Drilling and Remarks:

15" - 292

12" - 485

A. mhy. 834

Rng. 10"

RECORD

Cased _____ in., _____ ft.

Sand _____

Gas _____

Oil _____

Total Depth _____

PRODUCTION

1st 24 hrs. Nat. _____

1st 24 hrs. after shot _____

Gas _____ Cu. Ft.

Dry Hole _____

Abandoned _____

Date

AUG 31 1938

19

H. D. Hatfield

Scout

Map No. _____ Sec. 15 Twp. 14 R. 15WWell No. 2 Roubach "A"Wolf Creek Company _____

Contractor _____

COMPLETED

SE SW NE

_____ Ft. from N. Line

330 Ft. from S. Line

_____ Ft. from E. Line

990 Ft. from W. Line

SECTION PLAT

		0	

Location _____

Rig up _____

Drilling and Remarks:

POT 510

RECORD

Cased 7 in. 3213 ft.Sand Gorham 3216

Gas _____

Oil _____

Total Depth 3219

PRODUCTION

1st 24 hrs. Nat. _____

1st 24 hrs. after shot _____

Gas _____ Cu. Ft.

Dry Hole _____

Abandoned _____

Date

OCT 12 1938 19H. D. Hatfield Scout