



Company. Central Petroleum

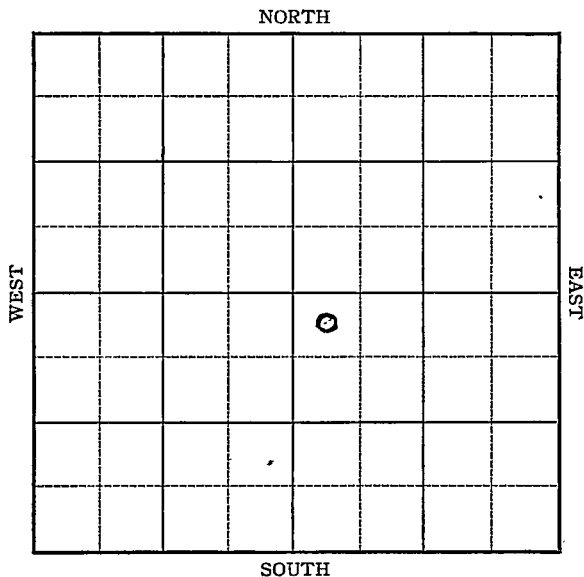

Central Petroleum Company

330 Ft. from W. Line

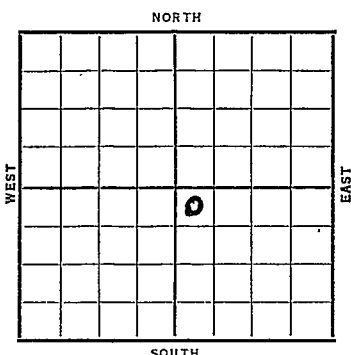

Date	REPORT
1938	
1/26	Location
2/4	Mat.
2/11	R. U.
2/18	15" @ 340'. 12" @ 352'.
	Anhy 836'. Drlg. 900'.
2/26	" " " "
3/4	10" @ 850'. 8" @ 2400'.
	Drlg. 2555'.
3/11	8" @ 2646'. Lans. 2968'.
	S.O. 2992'. S.O. & G 3040-45'.
	6" @ 3028'. WOC.
3/18	T.D. 3050'. 4000 acid.
3/25	Pumped 107 oil in 4 hrs.
	Deepened to 3200' T.D.
	5" at 3200'.
3/1	Testing.
	OVER

1938

4/6

6" @ 3028'.

5" liner 3200'.

Gorham 3200'.

T.D. 3211'.

Potential 638 bbls.

COMPLETED

Russell KANSAS

Map No. _____ Sec. 15 Twp. 14 R. 15WWell No. 1 Rouback "B"

_____ Central Petroleum Company

_____ Contractor

FIRST REPORT

NW SE

330 Ft. from N. Line

_____ Ft. from S. Line

_____ Ft. from E. Line

330 Ft. from W. Line

SECTION PLAT

		O	

Location X

Rig up _____

Drilling and Remarks:

RECORD

Cased _____ in., _____ ft.

Sand _____

Gas _____

Oil _____

Total Depth _____

PRODUCTION

1st 24 hrs. Nat. _____

1st 24 hrs. after shot _____

Gas _____ Cu. Ft.

Dry Hole _____

Abandoned _____

Date

JAN 26 1938 19 _____ H. D. Hatfield Scout

Russell **KANSAS**Map No. _____ Sec. 15 Twp. 14 R. 15^wWell No. 16 - Roubach "B"Central Pet Company

Contractor _____

CORRECTIONnw se330 Ft. from N. Line

_____ Ft. from S. Line

_____ Ft. from E. Line

330 Ft. from W. Line**SECTION PLAT**

		0	

Location _____

RECORD

Cased _____ in., _____ ft.

Sand _____

Gas _____

Oil _____

Total Depth _____

PRODUCTION

1st 24 hrs. Nat. _____

1st 24 hrs. after shot _____

Gas _____ Cu. Ft.

Dry Hole _____

Abandoned _____

Date

FEB 9 1938 19

H. D. Hatfield

Scout

Drilling and Remarks:

*first reported
as #1 has
been changed
to #16*

Russell KANSAS

Map No. 72 Sec. 15 Twp. 14 R. 15^wWell No. 1- Roubach "B"Central Pet Company

CORRECTION

Contractor

SECTION PLAT

		0	

330 Ft. from N. Line

_____ Ft. from S. Line

_____ Ft. from E. Line

330 Ft. from W. Line

CORRECTION

Location _____

Rig up _____

Drilling and Remarks:

*first reported
as #1- "B" Then
changed to #16- "B"
Now corrected
back to #1- "B"*

RECORD

Cased _____ in., _____ ft.

Sand _____

Gas _____

Oil _____

Total Depth _____

PRODUCTION

1st 24 hrs. Nat. _____

1st 24 hrs. after shot _____

"Gas _____ Cu. Ft.

Dry Hole _____

Abandoned _____

Date

H. D. Hatfield

MAR 23 1938 19

Scout

Russell KANSAS

Map No. 72 Sec. 15 Twp. 14 R. 15WWell No. 1 Rouback "B"Central Petroleum Company

Contractor

COMPLETED

NW SE

330 Ft. from N. Line Ft. from S. Line Ft. from E. Line330 Ft. from W. Line

SECTION PLAT

		0	

Location Rig up

Drilling and Remarks:

POT 638

6 - 3028

RECORDED

Cased 5 in. 3200 ft.Sand Gorham 3200Gas Oil Total Depth 3211

PRODUCTION

1st 24 hrs. Nat. 1st 24 hrs. after shot Gas Cu. Ft.Dry Hole Abandoned

Date

APR 6 - 1938

19

H. D. Hatfield

Scout