


Section 15 Township 14 Range 15-W

Well No. 2 Rouback "B"

Company Wolf Creek

NORTH Gorham Pool

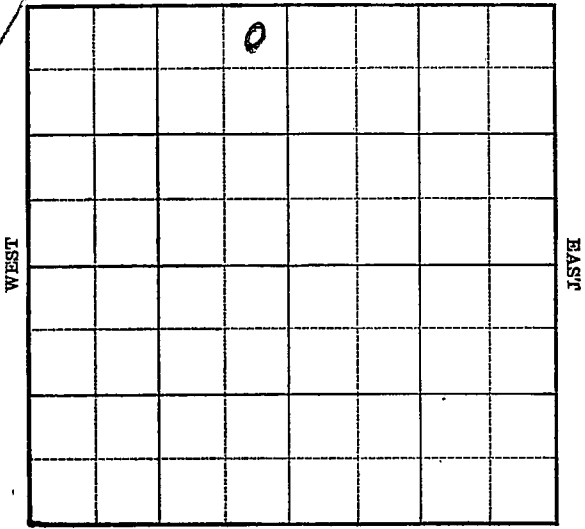

Sec. 15 Twp. 14 R. 15-W

Well No. #2 Rouback "B" Farm _____

Wolf Creek Company _____

(Gorham)


330 Ft. from N. Line

_____ Ft. from S. Line

330 Ft. from E. Line

_____ Ft. from W. Line

Elev. 1840

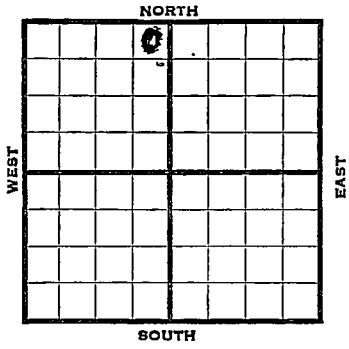

| 1939 | REPORT |
|------|--------------------------------|
| 4/26 | G. R. |
| 5/5 | Spud 150' |
| 5/12 | 15" - 335' 12" - 535' |
| | Anhy 873' 10" - 881' |
| | Drlg. 920' |
| 5/19 | Drlg. 1300' |
| 5/26 | 8" - 2445' Drlg. 2475' |
| 6/1 | 8" - 2467' S.G. 2697 to 2704' |
| | 7" - 2807' Drlg. 2835' |
| 6/8 | 3015' U.R. 7" |
| 6/16 | Lans. 3035' 7" - 3168' |
| | S.O. 3103-08' T.D. 3230' |
| 6/23 | 7" - 3241' Gorham 3244' |
| | T.D. 3250' 2000' oil 2 hrs. |
| | Run tubing. |
| 6/29 | T.D. 3252' 7" - 3246' |
| | 1600' oil 1 hour. |
| | Swab 80 bbis. oil per hour for |
| | 2 hours, 900' off bottom. |
| | OVER |

1939

7/5

Gorham 3244'

7" - 3246'

T.D. 3252'

Potential 1514 bbls., Pump.

COMPLETED

Russell

Map No. 72 Sec. 15 Twp. 14 R. 15WWell No. 2 Roubach "B"Wolf Creek

Company

Contractor

FIRST REPORT

NE NW

330 Ft. from N. Line

_____ Ft. from S. Line

330 Ft. from E. Line

_____ Ft. from W. Line

SECTION PLAT

| | | | |
|--|--|---|--|
| | | 0 | |
| | | | |
| | | | |
| | | | |

GORHAM POOL

Location X

Rig up _____

Drilling and Remarks:

CR

RECORD

Cased _____ in., _____ ft.

Sand _____

Gas _____

Oil _____

Total Depth _____

PRODUCTION

1st 24 hrs. Nat. _____

1st 24 hrs. after shot _____

Gas _____ Cu. Ft.

Dry Hole _____

Abandoned _____

Date

APR 26 1939 19

H. D. Hatfield Scout

Russell **KANSAS**

Map No. _____ Sec. **15** Twp. **14** R. **15W**

Well No. **2 Rouback "B"**

Wolf Creek

Company _____

Contractor _____

COMPLETED

NE NW

330 Ft. from N. Line

_____ Ft. from S. Line

330 Ft. from E. Line

_____ Ft. from W. Line

SECTION PLAT

| | | | | |
|--|--|---|--|--|
| | | o | | |
| | | | | |
| | | | | |
| | | | | |

GORHAM POOL

Location _____

Rig up _____

Drilling and Remarks:

Got ham 3244

7" C 3246

P & 1514 pump.

RECORD

Cased _____ in., _____ ft.

Sand _____

Gas _____

Oil _____

Total Depth **3252**

PRODUCTION

1st 24 hrs. Nat. _____

1st 24 hrs. after shot _____

Gas _____ Cu. Ft.

Dry Hole _____

Abandoned _____

Date

JUL 5 1939 19 _____

S. J. LEWIS Scout