

KANSAS

Russell


Form 51—5M—11-38—Palace

Section 15 Township 14 Range 15-W

Well No. #3 Rouback "B"

Company Wolf Creek

NORTH

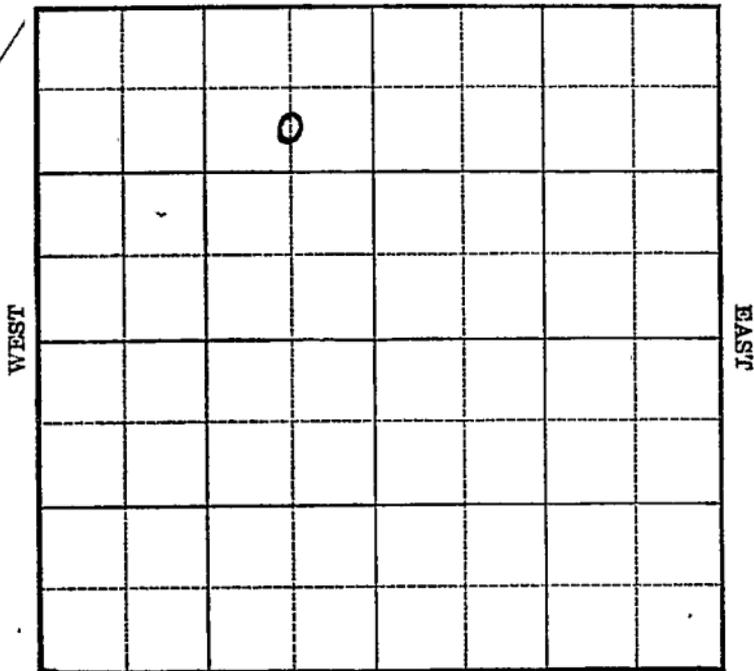

SOUTH

Sec. 15 Twp. 14 R. 15-W

Well No. #3 Rouback "B" Farm

Wolf Creek Company

(Gorham)


990 Ft. from N. Line

_____ Ft. from S. Line

660 Ft. from E. Line

_____ Ft. from W. Line

Elev. 1847

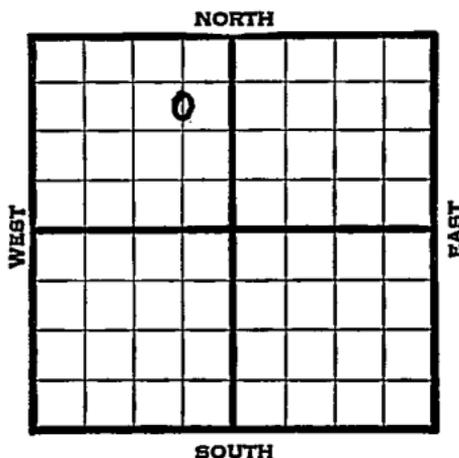

1939	REPORT
7/19	Cable Rig.
7/27	Spud 120'
8/3	15" - 338' 12" - 525'
	Anhy 870' 10" - 887'
	Drlg. 955'
8/10	Drlg. 1825'
8/17	8" - 2473' Drlg. 2495'
8/24	Topeka 2690' Lans. 3010'
	S.O. 3020-25' S.O. & W. 3110-
	3115' 6" - 3185' Drlg.
8/31	T.D. 3254' SD.
9/7	" " "
9/13	Gorham 3249'
	5" - 3249'
	T.D. 3258'
	Potential 2414 bbls., pump.
	COMPLETED

Russell **KANSAS**

Map No. 72 Sec. 15 Twp. 14 R. 15W

Well No. 3 Rouback "B"

Wolf Creek

Company

Contractor

FIRST REPORT

SECTION PLAT

990 C S $\frac{1}{2}$ NE NW
Ft. from N. Line

_____ Ft. from S. Line

660 Ft. from E. Line

_____ Ft. from W. Line

	o		

GORHAM POOL

Location _____

Rig up _____

Drilling and Remarks:

Cable Rig

RECORD

Cased _____ in., _____ ft.

Sand _____

Gas _____

Oil _____

Total Depth _____

PRODUCTION

1st 24 hrs. Nat. _____

1st 24 hrs. after shot _____

Gas _____ Cu. Ft.

Dry Hole _____

Abandoned _____

Date

JUL 19 1939 19

S. J. LEWIS

Scout

Map No. _____ Sec. 15 Twp. 14 R. 15W

Well No. 3 Rouback "B"

Wolf Creek

Company _____

Contractor _____

COMPLETED

C S $\frac{1}{2}$ NE NW

990 Ft. from N. Line

_____ Ft. from S. Line

660 Ft. from E. Line

_____ Ft. from W. Line

GORHAM POOL

SECTION PLAT

	o		

Location _____

Rig up _____

Drilling and Remarks:

Gas hole 3249

5" @ 3249

Pump 2414 P.D.

RECORD

Cased _____ in., _____ ft.

Sand _____

Gas _____

Oil _____

Total Depth *3258*

PRODUCTION

1st 24 hrs. Nat. _____

1st 24 hrs. after shot _____

Gas _____ Cu. Ft.

Dry Hole _____

Abandoned _____

Date

SEP 13 1939 19

S. J. LEWIS Scout