


KANSAS

Russell County

Section 15 , Township 14 Range ~~17W~~ 14W

Well No. #1 Boberger "B"

Company B. & R. Drlg.

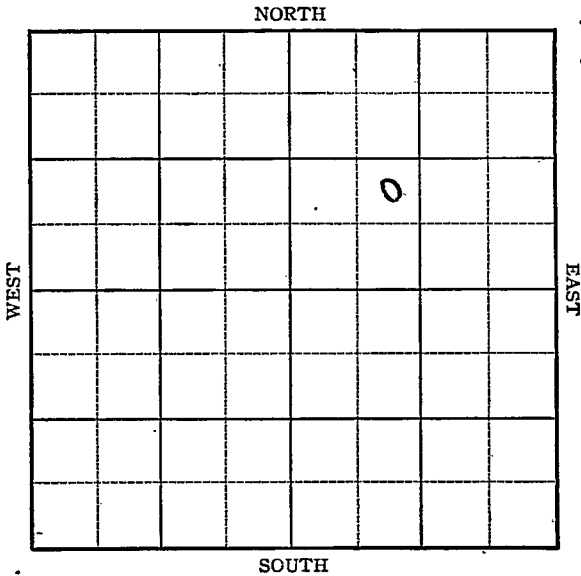

Sec. 15 Twp. 14 R. 14W 17N

Well No. #1, Boberger "B" Farm

B & R Drlg. Company

Hall-Gurney


 Ft. from N. Line

990 Ft. from S. Line

 Ft. from E. Line

9902 Ft. from W. Line

NE SW NE

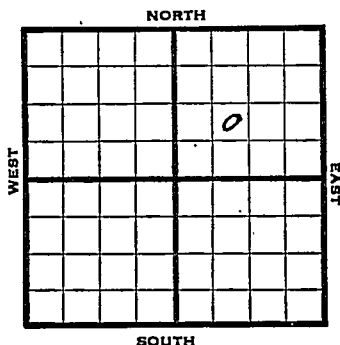

Elev. 1849

REPORT

1946

6/12 Drlg. 560'
6/18 10" @ 539'
Anhy 843'
Drlg 2505'
7/3 Granite "3261-7" @ 3002'
TD 3014'
Swb 4 oil PH 16 hrs
7/9 Swb 192 oil in 24 hrs
7/16 " " "
7/24 Lans 3001
Granite Wash 3261
7" @ 3002
PB 3100
TD 3270'
Pump 76 Pot.
Grav. 39.0

COMPLETED

KANSAS

Kansas

Pool Name Hall-Gurney

Map No. 71 Sec. 15 Twp. 14 R. 17W

Well No. 1 Boberger "B"

B. & R Drlg.

Company

FIRST REPORT

Contractor

NE SW NE

SECTION PLAT

Ft. from N. Line

990

Ft. from S. Line

Ft. from E. Line

990

Ft. from W. Line

Ellis

Russell County

Location

Rig up

Drilling and Remarks:

560

RECORD

Cased _____ in., _____ ft.

Sand _____

Gas _____

Oil _____

Total Depth _____

PRODUCTION

1st 24 hrs. Nat. _____

1st 24 hrs. after shot _____

Gas _____ Cu. Ft.

Dry Hole _____

Abandoned _____

Date

JUN 12 1946

19

S. J. LEWIS

Scout

KANSAS

Kansas

Pool Name Hall-Gurney PoolMap No. 72 Sec. 15 Twp. 14 R. 14WWell No. 1 Boxberger "B"

B & R Drlg.

Company

COMPLETED

Contractor

NE SW NE

SECTION PLAT

Ft. from N. Line

990 Ft. from S. Line

Ft. from E. Line

990 Ft. from W. Line

		6	

Russell County

Location

Rig up

Drilling and Remarks:

Lane 800!Granite Wash32617" C3002.PB8100Pump 76 P.D.3220

RECORD

Cased _____ in., _____ ft.

Sand _____

Gas _____

Oil _____

Total Depth 3270

PRODUCTION

1st 24 hrs. Nat. _____

1st 24 hrs. after shot _____

Gas _____ Cu. Ft.

Dry Hole _____

Abandoned _____

Date

JUL 24 1946 19

S. J. LEWIS

Scout

KANSAS Kansas Pool Name Hall-Gurney
 Map No. 72 Sec. 15 Twp. 14 R. 14W
 Well No. 1 Boxberger "B"

B. & R. Drlg.

Company

CORRECTION

Contractor

NE SW NE

SECTION PLAT

		o	

Ft. from N. Line

990

Ft. from S. Line

Ft. from E. Line

990

Ft. from W. Line

Russell County

RECORD

Location

Cased _____ in. _____ ft.

Rig up

Sand _____

Drilling and Remarks:

Gas _____

This is in 15-14-

Oil _____

14W

Total Depth _____

17W is in Ellis
County.

PRODUCTION

1st 24 hrs. Nat. _____

1st 24 hrs. after shot _____

Gas _____ Cu. Ft.

Dry Hole _____

Abandoned _____

Date

JUL 24 1946

19

S. J. LEWIS

Scout