

KANSAS

Russell

SECTION 15 TOWNSHIP 14 RANGE 14 W

WELL NO. #1 Boxberger "B"

COMPANY Sam Mizell

NORTH

WEST

EAST

						0	

SOUTH

Russell

KANSAS

SEC.	TWP.	R.
15-	14	14W

WELL NO.

#4 Boxberger "B"

FARM

COMPANY

Sam Mizell

CONTRACTOR

Trans- Era

Hall-Gurnery


Ft. from N. Line

Ft. from S. Line

Ft. from E. Line

Ft. from W. Line

NW SE NE

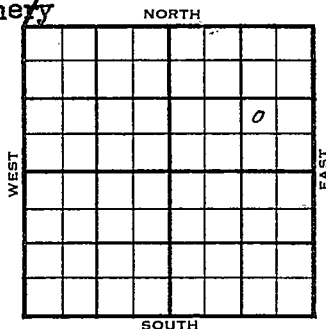

ELEVATION

REPORT

1956

1-18

Comm. 1-16-56
Rng. surface

County Russell Elev. _____
 Sec. 15 Twp. 14 Rge. 14W
 Company San Mizell
 Farm Name Boxberger "B" No. 1

TOPS	DEPTH	LOG	DATUM	Loc. in Sec.
Anh.				NW SE NE
Tr.				
H.				
Tr.				
Dg.				
Bl.				
L.				Geol.
K.C.				Contr.
B.K.C.				Trans-Era
Ce.				Pool
C.				Hall-Gurney
M.				
M.				
K.				
Mz.				
Mq.				
V.				
S.				
S.				
A.				
R.				
PE.				
G.				
T.D.				

Date Comm. 1-16-56
 ing. surface

JAN 18 1956	E
FIRST REPORT	

13



3

JAN 23 1956

R. G.

County

Haskell

Elev.

1848

Sec.

15

Twp.

14N

Rge.

14W

Company

San Misell

Farm Name

Barberger NW

No.

11

TOPS	DEPTH	LOG	DATUM	Loc. in Sec.
X Top of Hard	2375			NW SE NE
Tp. Top	2392			
H. 2nd Top	2409			
Tr. Top	2941			1650 NL
D. Top	2959			1200 EL
BL				
L.	3000		1152	Geol.
KC	3205		1357	Geol.
BKC				Cont.
Cc.				Trans-Era
C.				
M.				Pool
M.				Hall-Gurney
K.				
W.				
Ma.				
V.				
S.				
S.				
A.				
R.	3262		1414	
PC				
G.				
TD	3264			

Date Comm.

1-16-56

FEB 1 5 1956

FAB. SURFACE JAN 25 '56

8 5/8 @ 849

1000 # 2882, FEB 1 '56 X DST 3002-15
 on 1 hr. rec 10' oil speckled Md BHP
 35/20 DST 3033-44 on 1 hr. rec.
 30' SOCM + 60' WM BHP 695/20
 DST 3083-96 on 1 hr. 300' gas
 rec 65' Md 98554 oil + 55' MW
 BHP 725/20" BKC 3205 Reag.
 3262, RTD 3264 no log 5 1/2 @ 3263

MICAT CO FEB 8 '56 ✓ FEB 15 '56 CO VP
3272 tst 2 BF PB 3200
20/3092-96 ~~12~~ no tst.
top P 25 Bopd + Tr. wtr.

R.G.

FEB 27 1956