


Section 15 Township 14 Range 14-W

Well No. #2, Boxberger "B"

Company B&R Drilling Company

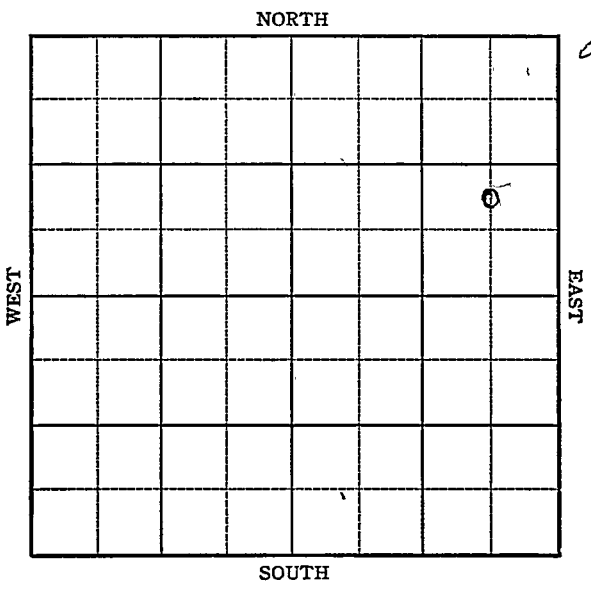

KANSAS

Russell County

Sec. 15 Twp. 14 R. 14WWell No. #2 Boxberger "B" Farm

B & R Drlg.

Company

Hall-Gurney


Ft. from N. Line

990 Ft. from S. Line

~~330~~ 660 Ft. from E. Line

Ft. from W. Line

NE SE NE

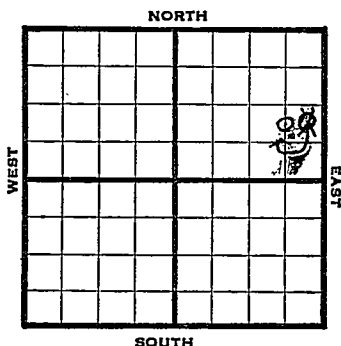

1946

1845

REPORT

8/28

RUR

9/5

10" @ 540' Anhy
 Anhy 840'
 Drlg 1875'

9/10

Topeka 2756'
 Drlg 2906'

9/18

Lans 2997'
 TD 3032
 7" @ 2997'
 SD 1000 acid

9/24

15 qts 3000-12 CO

10/1

TD 3043
 2000 acid
 Swb oil PH

10/9

Lans 2997'
 7" @ 2997'
 10,000 Acid
 Pump 25 POT
 TD 3043
 Grav. 39

COMPLETED

KANSAS

Pool Name

Hall-Gurney

Kansas

Map No. 72 Sec. 15 Twp. 14 R. 14WWell No. 2 Boxberger "B"

B & R Drllg.

Company

CORRECTION

Contractor

C N L SE NE

SECTION PLAT

 Ft. from N. Line990 Ft. from S. Line660 Ft. from E. Line Ft. from W. Line

			a

Russell County

Location Rig up

Drilling and Remarks:

Reported

NE SE NE

RECORD

Cased in., ft.Sand Gas Oil Total Depth

PRODUCTION

1st 24 hrs. Nat. 1st 24 hrs. after shot Gas Cu. Ft.Dry Hole Abandoned

Date

SEP 5 1946 19

S. J. LEWIS

Scout

Kansas Pool Name Hall-Gurney

KANSAS

Map No. 72 Sec. 15 Twp. 14 R. 14WWell No. 2 Boxberger "B"

B & R Drlg.

Company

FIRST REPORT

Contractor

NE SE NE

SECTION PLAT

			o

Ft. from N. Line

990 Ft. from S. Line

330 Ft. from E. Line

Ft. from W. Line

Russell County

Location

Rig up

Drilling and Remarks:

R U R

RECORD

Cased _____ in., _____ ft.

Sand _____

Gas _____

Oil _____

Total Depth _____

PRODUCTION

1st 24 hrs. Nat. _____

1st 24 hrs. after shot _____

Gas _____ Cu. Ft.

Dry Hole _____

Abandoned _____

Date

AUG 28 1946 19

S. J. LEWIS

Scout

Map No. 72 Sec. 15 Twp. 14 R. 14W

Well No. 2 Boxberger "B"

B & R Drlg. Company

COMPLETED

Contractor

C N L S E N E

E 1, 1845
SECTION PLAT

 Ft. from N. Line

990 Ft. from S. Line

660 Ft. from E. Line

 Ft. from W. Line

			0

Russell County

Location

Rig up

Drilling and Remarks:

Leas 2897
7" @ 2897
10000 ad
Pump 25 ft

289 = 6

RECORD

Cased in, ft.

Sand

Gas

Oil

Total Depth 3043

PRODUCTION

1st 24 hrs. Nat.

1st 24 hrs. after shot

Gas Cu. Ft.

Dry Hole

Abandoned

Date

OCT 9 1946 19

S. J. LEWIS

Scout