KANSAS


FORM 51 5M 1-42 PETROL

Russell

Section 15 Township 14 Range 14-W

Well No. #2 D. Boxberger

Company Texas

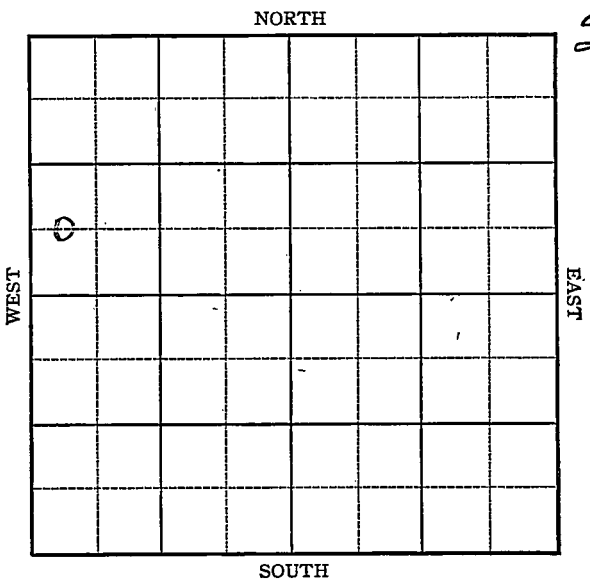

FORM 252-A
5M 9-43 GASS


KANSAS

Russell

Sec. 15 Twp. 14 R. 14-W

Well No. #2 D. Boxberger Farm

Texas Company

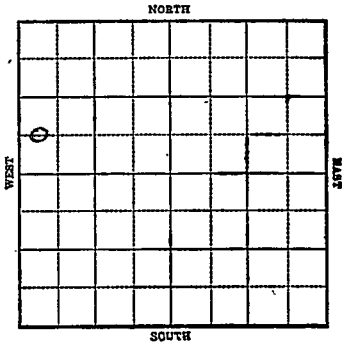

_____ Ft. from N. Line

660 Ft. from S. Line

_____ Ft. from E. Line

330 Ft. from W. Line

Elev. 1875

1944	REPORT
1-19	Location
1/26	10" @ 860' Drlg. 685'
2/2	Drlg. 2464'
2/8	Lans 3030-09 TD 7" @ 3032 RUST
2/15	TD 3060 Swb 68 oil 24 hrs.
2/23	7" @ 3032 Lans 3030 TD 3060 4000 acid Pump 283 Pot. Gravity 36.7

COMPLETED

Form 26 200 Blks 5-42 Petrol KANSAS Russell

Map No. 7 r Sec. 15 Twp. 14 R. 14W


Well No. 2 D. Boxberger

Texas Company

FIRST REPORT Contractor

C W L SW NW

SECTION PLAT

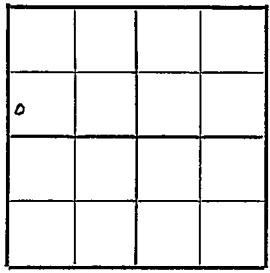

____ Ft. from N. Line

660 Ft. from S. Line

____ Ft. from E. Line

330 Ft. from W. Line

Hall-Gurney Pool

Location X

Rig up

Drilling and Remarks:

RECORD

Cased ____ in., ____ ft.

Sand

Gas

Oil

Total Depth

PRODUCTION

1st 24 hrs. Nat.

1st 24 hrs. after shot

Gas ____ Cu. Ft.

Dry Hole

Abandoned

Date

JAN 19 1944 19 S. J. LEWIS Scout

Form 26 200 Bks 5-42 Petrol

Russell

KANSAS

Map No. 7 2S Sec. 15 Twp. 14 R. 14W


Well No. 2 D. Boxberger

Texas Company

COMPLETED Contractor

C W L SW NW

SECTION PLAT

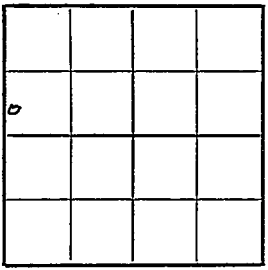

Ft. from N. Line

660 Ft. from S. Line

Ft. from E. Line

330 Ft. from W. Line

Williamson Pool

Location

Rig up

Drilling and Remarks:

Lane 3030

7" C 3032

4000 Acid

Pump 283 Bbl

362 Gr

RECORD

Cased in., ft.

Sand

Gas

Oil

Total Depth 3060

PRODUCTION

1st 24 hrs. Nat.

1st 24 hrs. after shot

Gas Cu. Ft.

Dry Hole

Abandoned

Date

FEB 23 1944 19

S. J. LEWIS Scout