

KANSAS

FORM 51 5M 1-42 PETROL

Q. W. P. B


Russell

Section 15 Township 14 Range 14-W

Well No. #1 Fink

Company ~~Cordena~~ CRA

Semi-Wilcat (NORTH

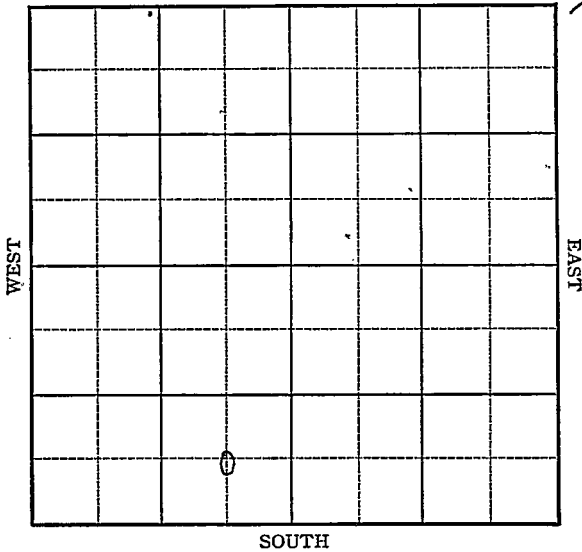

Sec. 15 Twp. 14 R. 14W

Well No. #1 Fink Farm _____
Coralena Company _____


Semi Wildcat

_____ Ft. from N. Line

510 Ft. from S. Line

660 Ft. from E. Line

_____ Ft. from W. Line

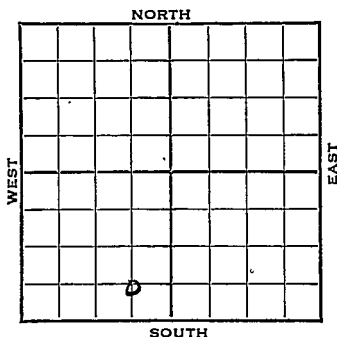

C SE SW

1942	REPORT
11/10	Rotary
11/18	Drlg. 1900 10" @ 109 Anhy 865
11/24	Drlg. 3023'
12/2	Lans. 3031 7" @ 3250 Rust
12/9	"
12/16	Granite Wash 3288 TD PB 3259-1000 acid.
12/22	1000 acid Pump 2 bbls oil per hr. Plus 6% water.
12/29	Lansing 3031 Granite 3290 5" @ 3244' T.D. 3310' PB 3259' 6000 gals. acid Pump 179 pot. Gravity 40.8

COMPLETED

Russell

KANSAS
 Map No. 2 Sec. 15 Twp. 14 R. 14W

Well No. 1 Fink

Coralena Company

FIRST REPORT Contractor

C SE SW

_____ Ft. from N. Line

510 Ft. from S. Line660 Ft. from E. Line

_____ Ft. from W. Line

SEMI WILDCAT

SECTION PLAT

Location _____

Rig up _____

Drilling and Remarks:

Rotary

RECORD

Cased _____ in., _____ ft.

Sand _____

Gas _____

Oil _____

Total Depth _____

PRODUCTION

1st 24 hrs. Nat. _____

1st 24 hrs. after shot _____

Gas _____ Cu. Ft.

Dry Hole _____

Abandoned _____

Date

NOV 11 1942

19

S. J. LEWIS

Scout

KANSAS

Russell

Map No. 72 Sec. 15 Twp. 14 R. 14W

Well No. 1 Fink

Coralena Company

COMPLETED Contractor

C SE SW

SECTION PLAT

_____ Ft. from N. Line

510 Ft. from S. Line

660 Ft. from E. Line

_____ Ft. from W. Line

SEMI-WILDCAT

Location _____

Rig up _____

Drilling and Remarks:

*Landing 3031
 Grant 3290
 5" C 3244
 PB 3259
 6000 acid
 Pump 179 Pst.
 40 E Se*

RECORD

Cased _____ in., _____ ft.

Sand _____

Gas _____

Oil _____

Total Depth 3310

PRODUCTION

1st 24 hrs. Nat. _____

1st 24 hrs. after shot _____

Gas _____ Cu. Ft.

Dry Hole _____

Abandoned _____

Date

DEC 29 1942 19

S. J. LEWIS Scout

O. W. P. B.

FORM 513 SUNRAY

County Russell Elev. _____
 Sec. 15 Twp. (14) S Rgs. 14W
 Company G R A
 Farm Name Fink No. 1

TOPS	DEPTH	LOG	DATUM	Loc. in Sec.
Anh.				C SE SW
Tp.				
H.				510' SL
Tr.				
Dg.				660' EL
BL.				DWPB
L.				Geol.
K.C.	3031			Contr.
B.K.C.				
Ce.				
C.				
M.				Pool
M.				Hall-Gurney
K.				
Mz.				
Me.				
V.				
S.				
S.				FIRST REPORT
A.				JAN 3 '57
R.				
PE.				COMPLETE
G.T. Wash.	3290			
T.D.	3310			

Date Comm. _____
 5" @ 3244 PB 3259 00 to 3168
 28/ 3131-38 32/ 3054-62 6000 A
 P/ 7.98 bo 26.37 bwpd Comp.
 Well in Unit all right

~~13~~