


O. W. D. D

Section 15 Township 14 Range 14-W

Well No. #1 F. Fink

Company SKA Carolina

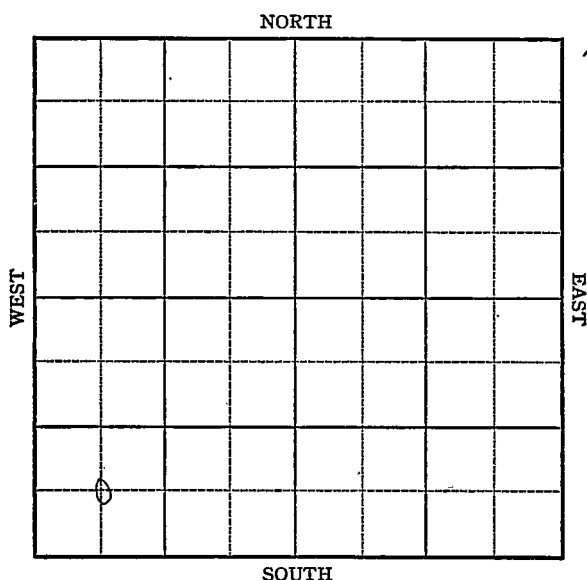

KANSAS

Russell

Sec. 15 Twp. 14 R. 14-W

Well No. #1 E. Fink Farm

CRA
Coralena Company

Hall-Gurney


 Ft. from N. Line

660 Ft. from S. Line

 Ft. from E. Line

660 Ft. from W. Line

Elev. 1889

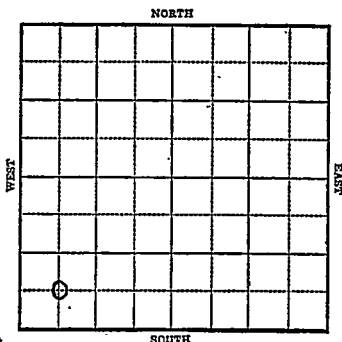

1943

Elev. 1889' R E P O R T

3/17

Spud 3113-43
10" Casing set 100'
Drlg. 804'

3/24

Anhy 865
Topeka 2753
Drlg. 2825'

3/31

Lans 3037 7" @ 3035 TD 3075 SD

4/14

Lans 3037
7" @ 3035'
T.D. 3075'
4000 gal. acid
Pump 426 bbls oil plus 7% water pot.
Gravity 39

COMPLETED

O. W. D. D

1951

8/15

Oil Well TD 3139
KC 3037
7" @ 3035 OTD 3075
DD 3113 Ran 5 1/2" liner DD 3139
4 boph 2500 A Comp. 76 bo 164 bwpd

FIRST REPORT

COMPLETED

KANSAS

Russell

Map No. 72 Sec. 15 Twp. 14 R. 14WWell No. 1 F. FinkCoralena

Company

COMPLETED

Contractor

C SW SW

SECTION PLAT

6			

Ft. from N. Line

660

Ft. from S. Line

Ft. from E. Line

660

Ft. from W. Line

HALL-GURNEY POOL

Location _____

Rig up _____

Drilling and Remarks:

*Lease 3087**7" C 3035**4000 acid**Pump 426 in 67**7% Water P & Y.**39° - 41°*

RECORD

Cased _____ in., _____ ft.

Sand _____

Gas _____

Oil _____

Total Depth 3025

PRODUCTION

1st 24 hrs. Nat. _____

1st 24 hrs. after shot _____

Gas _____ Cu. Ft.

Dry Hole _____

Abandoned _____

Date

APR 14 1943

19

S. J. LEWIS

Scout

Russell

KANSAS

Map No. 72 Sec. 15 Twp. 14 R. 14WWell No. 1 F. FinkCoralena

Company

FIRST REPORT

Contractor

C S W S W

 Ft. from N. Line660 Ft. from S. Line Ft. from E. Line660 Ft. from W. Line**SECTION PLAT**

o			

HALL - GURNEY POOLLocation Rig up

Drilling and Remarks:

Spud 3/13/43

10"-100'

Drlg. 804'

RECORDCased in., ft.Sand Gas Oil Total Depth **PRODUCTION**1st 24 hrs. Nat. 1st 24 hrs. after shot Gas Cu. Ft.Dry Hole Abandoned

Date

MAR 17 1943 19S. J. LEWIS

Scou

County Russell State Kansas
 Sec. 15 (Blk. 74) (Sur. 14W) Map No. 14W
 Operator C R A (was Coralena)
 Well No. 3 Farm H. Fink
 Elev. 1390 Location C SW SW



660 Ft. From S Line SW
660 Ft. From W Line Quarter
 Ist. Report AUG 15 1951
 Completion AUG 15 1951
 Remarks GWDD

Spudding Date _____

Drig. Data Oil well TD 3139 Hall-Gurney Pool

KG 3037 7" @ 3035 OTD 3075

DD 3113 ran 5 1/2" liner DD 3139

4 boph 2500 A Comp. 76 bo 164 bwpd