


Section 15 Township 14 Range 15-W

Well No. #8 A. H. Rouback

Company Central Petroleum

Gorham Pool

NORTH

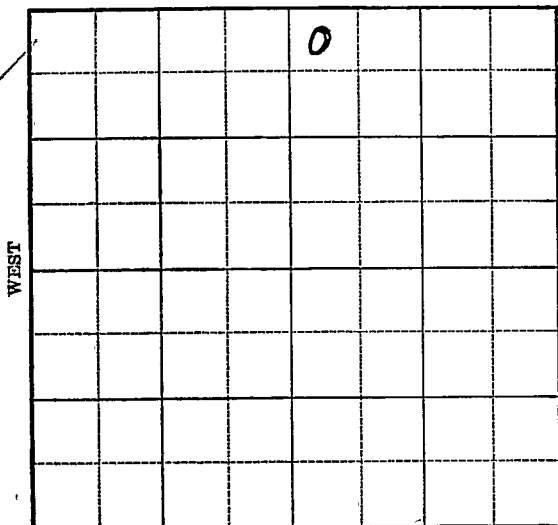

SOUTH

Sec. 15 Twp. 14 R. 15-W

Well No. #8 A. H. Rouback Farm

Central Petr. Company

(Gorham)


330 Ft. from N. Line

\_\_\_\_\_ Ft. from S. Line

\_\_\_\_\_ Ft. from E. Line

330 Ft. from W. Line

Elev. 1845

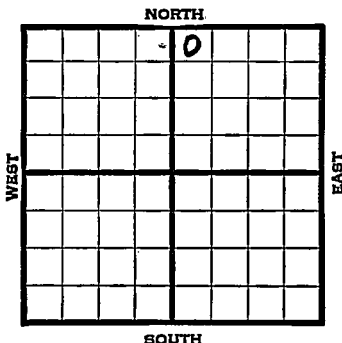

| 1939 | REPORT                         |
|------|--------------------------------|
| 6/21 | Cellar.                        |
| 6/29 | Machine.                       |
| 7/6  | Cable Rig.                     |
| 7/13 | " "                            |
| 7/20 | 30' of 20" conductor.          |
|      | T.D. 592' Run 12½".            |
| 7/27 | 12" - 592' Anhy 885'           |
|      | 10" - 895' Drlg. 1550'         |
| 8/3  | 8" - 2480' Drlg. 2550'         |
| 8/10 | 2285' crooked hole.            |
| 8/17 | 8" - 2590' Drlg. 2740'         |
| 8/24 | Topeka 2680' 8" - 2733'        |
|      | Lans. 3020' 6" - 3040'         |
|      | S.O. 3050-60' Drlg. 3150'      |
| 8/31 | T.D. 3265' 3000' oil 12 hours. |
| 9/7  | On potential.                  |
|      | OVER                           |

Russell **KANSAS**

Map No. \_\_\_\_\_ Sec. **15** Twp. **14** R. **15W**

Well No. **8 A. H. Rouback**

**Central Petroleum** Company

Contractor

**FIRST REPORT**

NW NE

**330** Ft. from N. Line

\_\_\_\_\_ Ft. from S. Line

\_\_\_\_\_ Ft. from E. Line

**330** Ft. from W. Line

**SECTION PLAT**

|  |  |   |  |
|--|--|---|--|
|  |  | 0 |  |
|  |  |   |  |
|  |  |   |  |
|  |  |   |  |

**GORHAM POOL**

Location \_\_\_\_\_

Rig up \_\_\_\_\_

Drilling and Remarks:

**Cellar**

**RECORD**

Cased \_\_\_\_\_ in., \_\_\_\_\_ ft.

Sand \_\_\_\_\_

Gas \_\_\_\_\_

Oil \_\_\_\_\_

Total Depth \_\_\_\_\_

**PRODUCTION**

1st 24 hrs. Nat. \_\_\_\_\_

1st 24 hrs. after shot \_\_\_\_\_

Gas \_\_\_\_\_ Cu. Ft.

Dry Hole \_\_\_\_\_

Abandoned \_\_\_\_\_

Date

**JUN 21 1939** 19

**S. J. LEWIS** Scout

Map No. \_\_\_\_\_ Sec. 15 Twp. 14 R. 15W

Well No. 8 A. H. Rouback

Central Petroleum Company

Contractor

COMPLETED

SECTION PLAT

NW NE

330 Ft. from N. Line

\_\_\_\_\_ Ft. from S. Line

\_\_\_\_\_ Ft. from E. Line

330 Ft. from W. Line

|  |  |   |  |
|--|--|---|--|
|  |  | 0 |  |
|  |  |   |  |
|  |  |   |  |
|  |  |   |  |

GORHAM POOL

Location \_\_\_\_\_

Rig up \_\_\_\_\_

Drilling and Remarks:

*GORHAM 2261*  
*5" @ 2258.*  
*Pump 2472 P.J.*

RECORD

Cased \_\_\_\_\_ in., \_\_\_\_\_ ft.

Sand \_\_\_\_\_

Gas \_\_\_\_\_

Oil \_\_\_\_\_

Total Depth 2265

PRODUCTION

1st 24 hrs. Nat. \_\_\_\_\_

1st 24 hrs. after shot \_\_\_\_\_

Gas \_\_\_\_\_ Cu. Ft.

Dry Hole \_\_\_\_\_

Abandoned \_\_\_\_\_

Date

SEP 13 1939 19

S. J. LEWIS Scout

1939

9/13

Gorham 3261'

5" - 3258'

T.D. 3265'

Potential 2472 bbls., pump.

COMPLETED