

Section 16 Township 14 Range 16 W

Well No. # 1 Hertel

Company Flourney, Haston & Anschutz

NORTH

			0				

SOUTH

WEST

EAST

Ellis

KANSAS

O.W.W.O.

Sec. 16 Twp. 14 R. 16 W

Well No. # 1 Hertel Farm

Flourney, Haston & Anschutz Company

Flourney Contractor


330 Ft. from N. Line

Ft. from S. Line

330 Ft. from E. Line

Ft. from W. Line

NE NE NW

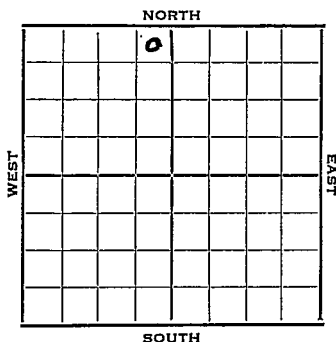

1952 Elev. 1881' REPORT

4/23 MIR

4/30 8" @ 165'
Anhy 1035'
Drlg. 2423'

5/7 Heeb 3076' Tor 3095' Lans. 3124'
DST 3126-52 1 1/4 hrs. 240' O & GCM
150' wtr. 950#
DST 3182-94 1 1/4 hrs. 105' VSO & GCM
980# Cherty Cong. 3374' Arb. 3383'
RTD 3385'
DST 3384-91 hr. 40' oil 30' MCO
TD 3391'

5/14 5" @ 3384 DP 3391
B/18 galsoph 500 A S/7 1/2 Bfph
98% wtr PB 3190 23/3164-72
B/3/4 BOPH & SSW for 4 hrs.
500 A S/90 BO 11 hrs.

5/21 NR

5/28 "

OVER

1952

6/4 Spud 4-22-52
Oil Well TD 3391
8" @ 165 - Anhy 1035
Heeb. 3076 Tor. 3095
Lans. 3124
DST 3126-52 opn $1\frac{1}{4}$ hr. Rec. 240'
O&GCM 150' wtr
DST 3182-94 opn $1\frac{1}{4}$ hr. Rec. 105'
vso & gcm Cong. 3374
Arb. 3383 TD 3385
DST 3384-91 opn 1 hr. Rec. 40' oil
30' mco TD 3391 5" @ 3384
DP to 3391 B/18 goph 500
S/ $7\frac{1}{2}$ bfph 98% wtr. PB 3190
23/3164-72 B/3/4 boph SSW
500 A S/90 bo 11 hr.
Comp. 76 bopd 52% wtr.

COMPLETED

1952

O.W.W.O.

7/9 Heeb 3076' Tor. 3095' Lans. 3124'
Cong. 3374' Arb. 3383' OTD 3390'
5" @ 3384' PB 3224' 24/3194-3200
500 A water PB 3186' 12/3162-67
500 A S/1 BFPH 20% water
SP 3151' 24/3122-32 500 A
S/ $6\frac{1}{2}$ BFPH

7/17 P/52 BO & 14 BW 10 hrs.
P/105 BO & $29\frac{1}{2}$ BW 15 hrs.

7/23 P/ 161 Bo & 20 Bwpd

7/30 P/10 BOPH

8/6 NR

8/13 "

8/20 Oil Well TD 3390
Heeb. 3076 Tor. 3095
Lans. 3124 Cong. 3374
Arb. 3383 OTD 3390
5" @ 3384 PB 3224 24/3194-3200
500 A wtr PB 3186 12/3162-67
500 A S/1bfph 20% wtr SP 3151
24/3122-32 500 A S/ $6\frac{1}{2}$ bfph
P/52 bo 14 bw 10 hr. P/105 bo
 $29\frac{1}{2}$ bw 15 hr. P/161 bo 20 bwpd
Comp. 100 bopd 26 bw

COMPLETED

County Ellis State Kansas
 Sec. 16 (Blk. 14 (Sur. 16W Map No.
 (Twp.) (Rge.)
 Operator Flourney, Haston & Anschutz
 Well No. 1 Farm Hertel
 Elev. Location NE NE NW

			0				

FIRST FLECK

330 Ft. From N Line NW
330 Ft. From E Line Quarter
 1st. Report APR 23 1952
 Completion
 Remarks
Flourney - Contr.
 Spudding Date

Drlg. Data

M I R


J. G. McGEHEE

APR 25 1952

Land Well Map	
Tracings	
France Map	
Pierce Map	
Misc.	

Drig. Data

County Ellis State Kansas
 Sec. 16 (Blk. 14) (Sur. 16W) Map No. 16W
 Operator Flourney, Haston & Anschutz
 Well No. 1 Farm Hertel
 Elev. 1881 Location NE NE NW

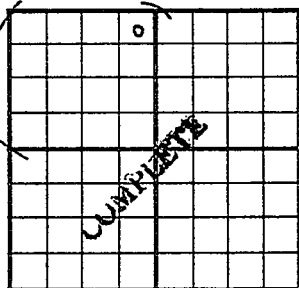

330 Ft. From N Line NW
330 Ft. From E Line Quarter
 1st. Report
 Completion JUN 4 1952
 Remarks

Flourney - Contr.

Spudding Date 4-22-52

Drlg. Data Oil well TD 3391

8" @ 165 Anhy 1035 Heeb. 3076

Tor. 3095 Lans. 3124 DST 3126-52

open 1 1/4 hr. Rec. 240' o & gcm 150' wtr.

DST 3182-94 open 1 1/4 hr. Rec. 105' vso

& gcm Cong. 3374 Arb. 3383 TD 3385

DST 3384-91 open 1 hr. Rec. 40' oil

30' mco TD 3391 5" @ 3384 DP to 3391

B/ 18 goph 500 A S/ 7 1/2 bfph 98% water

PB 3190 23/ 3164-72 B/ 3/4 boph SSW

500 A S/ 90 bo 11 hr.

Comp. 76 bopd 52% water

J. G. McGEHEE

Scout Cards	20
Land Small Map	
Land Wall Map	3
Tracings	
France Map	
Pierce Map	
Misc	

1952

Drig. Data

O.W.W.O.

County Ellis State KansasSec. 16 (Blk. 14 (Sur. 16W Map No. 14 (Rge. 16W)Operator Flourney & Hasten & AnschutzWell No. 1 Farm HertelElev. 1881 Location NE NE NW

		0			

330 Ft. From N Line NW330 Ft. From E Line Quarter1st. Report JUL 9 1952

Completion

Remarks

O.W.W.O.

O.W.W.O.

Spudding Date

Drlg. Data

Heeb. 3076 Tor. 3095 Lans. 3124

Cong. 3374 Arb. 3383 OTD 3390 5" @ 3384

PB 3224 24/ 3194-3200 500 A water

PB 3186 12/ 3162-67 500 A S/ 1 bfph

20% water SP 3151 24/ 3122-32 500 A

S/ 6½ bfph

J. G. McGEHEE

JUL 11 1952

Scout Cards	700 700
Land Small Map	
Land Wall Map	3
Tracings	
France Map	
Pierce Map	
Misc	

Drig. Data

County Ellis State Kansas
 Sec. 16 (Blk. 14) (Sur. 16W) Map No. 16W
 Operator Flourney & Hasten & Anschutz
 Well No. 1 Farm Hertel
 Elev. 1881 Location NE NE NW

			0				

330 Ft. From N Line NW

330 Ft. From E Line Quarter

1st. Report

Completion AUG 20 1952Remarks OWWO

Spudding Date

Drig. Data Oil well TD 3390Heeb. 3076 Tor. 3095 Lans. 3124Cong. 3374 Arb. 3383 OTD 3390 5" @3384 PB 3224 24/ 3194-3200 500 Awater PB 3186 12/ 3162-67 500 AS/ 1 bfph 20% water SP 315124/ 3122-32 500 A S/ 6½ bfphP/ 52 bo 14 bw 10 hr. P/ 105 bo29½ bw 15 hr. P/ 161 bo 20 bwpdComp. 100 bopd 26 bw

J. G. McGEHEE

SEP 2 1952

Scout Cards	OK
Land Small Map	
Land Wall Map	
Tracings	
France Map	
Pierce Map	
Misc.	