


Section 16 Township 14 Range 16WWell No. #1 BerensCompany Murfin Drlg.

NORTH

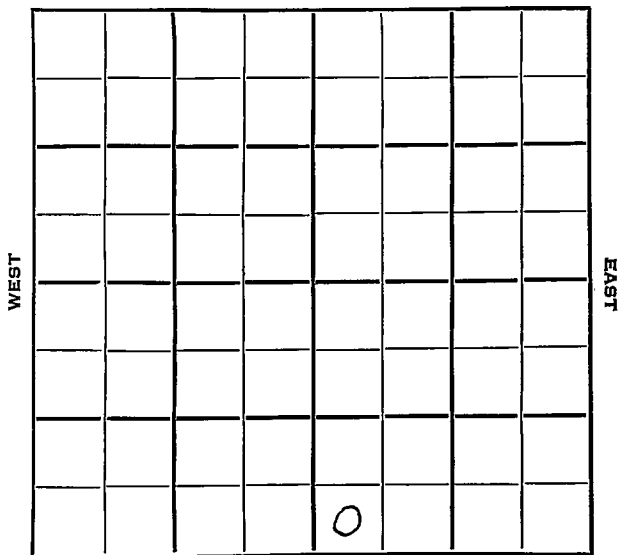

SOUTH

KANSAS

Sec. 16 Twp. 14 R. 16W ②

Well No. #1 Berens Farm

Murfin Drlg.

Company

Murfin Drlg.

Contractor

Dreiling Pool

NORTH


Ft. from N. Line

330 Ft. from S. Line

Ft. from E. Line

330 Ft. from W. Line

SW SW SE

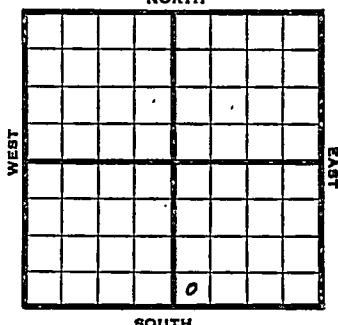

1953

Elev. 1868'

REPORT

8/19

Spud 8-12-53

8" @ 200"

Anhy 978:

Drlg 2880:

8/26

Spud 8-12-53 D & A TD 3425

8th @ 200 Anhy 978 Heeb 3074

Tor. 3098 Lans 3119

DST 3143-70 open 1 hr rec 330' mud


DST 3200-25 open 1 hr rec 65.1 MCW

850# Cong 3371 Arb. 3407

TD 3425 D & A

ABANDONED

County Ellis State Kansas
 Sec. 16 (Blk.) 14 (Sur.) 16W Map No.
 Operator Murfin Drlg.
 Well No. 1 Farm Berens
 Elev. 1868 Location SW SW SE

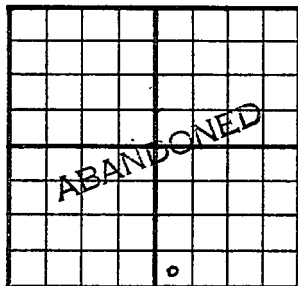

330 Ft. From S Line SE
330 Ft. From W Line Quarter

1st. Report

Completion AUG 26 1953

Remarks Dreiling Pool
Murfin Drlg. - Contr.

Spudding Date 8-12-53

Drlg. Data D & A TD 3425

8" @ 200 Anhy 978 Heeb. 3074

Tor. 3098 Lans, 3119 DST 3143-70

open 1 hr. Rec. 330' mud DST 3200-25

open 1 hr. Rec. 65' mcw 850#

Cong. 3371 Arb. 3407 TD 3425

D & A

J. G. McGEHEE

J. G. McGEHEE