

Section 16 Township 14 Range 16W
Well No. 1 Burns
Company Stearns Pet.

NORTH

						0	

SOUTH

WEST

EAST

Ellis

KANSAS

SEC.	TWP.	R.
16	14	16W

WELL NO.

#1 Burns

FARM

COMPANY

Stearns Pet.

CONTRACTOR

Co. Tools.


Dreiling Pool

_____ Ft. from N. Line

330 _____ Ft. from S. Line

990 _____ Ft. from E. Line

_____ Ft. from W. Line

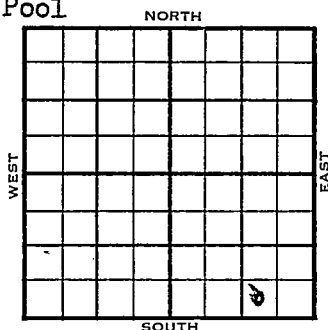

SW SE SE

1955

ELEVATION

1881'

REPORT

3/9

Spud 3-5-55

8" @ 227'

Drlg. 2875'

4/13

Spud 3-5-55 Oil well TD 3398

8" @ 227' Lans. 3130

DST 3131-61 open $\frac{1}{2}$ hr rec 130' SW 738#

DST 3181-3211, open 1 hr, rec

~~25~~ 25' mud, 80# Arb. 3394


TD 3396 5" @ 3394 DD 3398

2000 A S/2 BOPH 6 hr.

Comp. 40 BOPD

COMPLETED

FABEN GILSTRAP

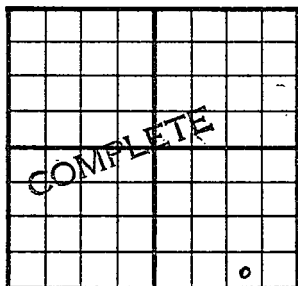County Ellis State KansasSec. 16 (Blk.
Twp.) 14 (Sur.
Rge.) 16W Map No.Operator Stearns Pet.Well No. 1 Farm BurnsElev. 1881 Location SW SE SE330 Ft. From S Line SE990 Ft. From E Line Quarter1st. ReportCompletion APR 13 1955Remarks Dreiling PoolCo. toolsSpudding Date 3-5-55Drlg. Data Oil well TD 33988" @ 227 Lans. 3130 DST 3131-61open $\frac{1}{2}$ hr. Rec. 130' sw 738#DST 3181-3211 open 1 hr. Rec. 25' mud80# Arb. 3394 TD 3396 5" @ 3394DD 3398 2000 A S/ 2 bopd 6 hr.Comp. 40 bopd

FABEN GILSTRAP