
FORM 51 25M 8-50 WESTERN

Russell KANSAS

Section 16 Township 14 Range 15W

Well No. #1 Rouback

Company Gross Drlg.

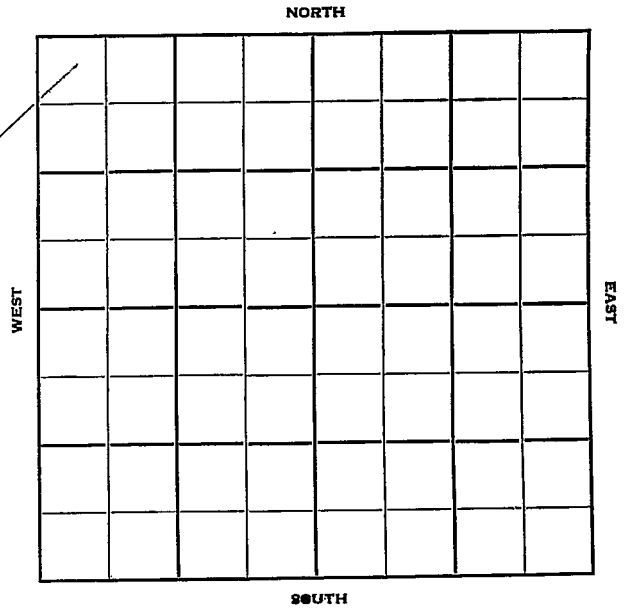

FORM 252-B
10M 10-50 PETROL

Russell KANSAS

Sec. 16 Twp. 14 R. 15W

Well No. #1 Rouback Farm

Gross Drlg. Company

Contractor

Gorham Pool


660' Ft. from N. Line

Ft. from S. Line

660' Ft. from E. Line

Ft. from W. Line

C NE NE

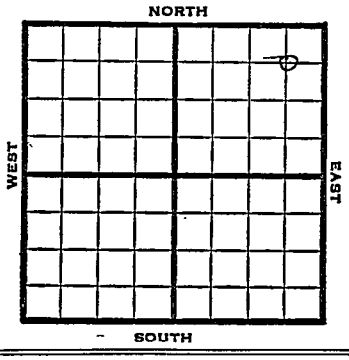

1950	REPORT
11/22	Spud 11-13-50 D&A TD 3296 8" @ 304' Top. 2741' Lans. 3028' Granite Wash 3245-96 TD D&A FIRST REPORT ABANDONED

FORM 275 FOR SALE BY KANSAS BLUE PRINT CO.


County Russell State Kansas

Sec. 16 (Blk. Twp.) 14 (Sur. Rge.) 15W Map No.

Operator Gross Drlg.

Well No. 1 Farm Rouback

Elev. 1857 Location C NE NE

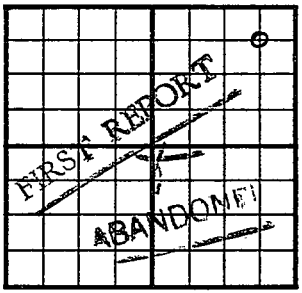

660 Ft. From N Line NE

660 Ft. From E Line Quarter

1st. Report NOV 2 2 1950

Completion NOV 2 2 1950

Remarks

Spudding Date 11-13-50

Drlg. Data D & A TD 3296 Gorham Pool

8" @ 304 Top. 2741 Lans. 3028

Granite Wash 3245-96 TD D & A

J. E. TYRA