

KANSAS

Form 51-5M-7-40-Palace

Russell

Section 16 Township 14 Range 15-W

Well No. #1 M. C. Ball Estate

Company Haynes & Anschutz

NORTH Big Creek Pool

			0						

SOUTH


Sec. 16 Twp. 14 R. 15-WWell No. #1 M. C. Ball Est. FarmHaynes & Anschutz Company

(Big Creek)

990 Ft. from N. Line~~330~~ Ft. from S. Line330 Ft. from E. Line

Ft. from W. Line

Elev. 1864

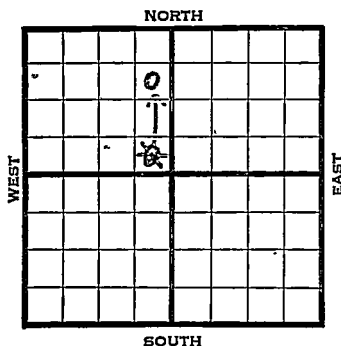

1940	REPORT
11/13	Location
11/21	"
11/27	Spud.
12/5	15" - 335' 563' run 12".
12/12	12" - 558' Anhy 914'
	10" - 920' Drlg. 1230'
12/19	Drlg. 2170'
12/26	Drlg. 2325'
1941	
1/2	8" - 2525' SO 2780-83'
	T.D. U.R. 8".
1/9	Arb. 3261' 5" - 3254'
	T.D. 3263½' 1400' oil 1½ hrs.
1/16	Topeka 2780' 8" - 2780'
	T.D. 2794' 1000 acid.
	Swab 120 bbls. oil in 2 hours.
1/23	" " "
1/30	3000 acid. Estimate 1800 bbls on Echometer.
2/6	" " "
2/13	Potential 2179 bbls.

OVER

Map No. 72 Sec. 16 Twp. 14 R. 15W

Well No. 1 M. C. Ball Est.

Haynes & Anschutz Company

Contractor

FIRST REPORT

SE NW

 Ft. from N. Line

330 Ft. from S. Line

330 Ft. from E. Line

 Ft. from W. Line

SECTION PLAT

BIG CREEK POOL

Location X

Rig up

Drilling and Remarks:

RECORD

Cased in., ft.

Sand

Gas

Oil

Total Depth

PRODUCTION

1st 24 hrs. Nat.

1st 24 hrs. after shot

Gas Cu. Ft.

Dry Hole

Abandoned

Date

NOV 13 1940 19

S. J. LEWIS Scout

Map No. 72 Sec. 16 Twp. 14 R. 15W

Well No. 1 M. C. Ball Estate

Haynes & Anschutz Company

CORRECTION Contractor

SECTION PLAT

SE NE NW

990 Ft. from N. Line

 Ft. from S. Line

330 Ft. from E. Line

 Ft. from W. Line

BIG CREEK POOL

Location _____

Rig up _____

Drilling and Remarks:

Reported
SE NW

RECORD

Cased _____ in., _____ ft.

Sand _____

Gas _____

Oil _____

Total Depth _____

PRODUCTION

1st 24 hrs. Nat. _____

1st 24 hrs. after shot _____

Gas _____ Cu. Ft.

Dry Hole _____

Abandoned _____

Date

NOV 21 1940 19

S. J. LEWIS Scout

Map No. _____ Sec. 16 Twp. 14 R. 15WWell No. 1 M.C. Ball Estate

_____ Haynes & Anschutz _____ Company

_____ **COMPLETED** _____ Contractor

SECTION PLAT

SE NE NW

990 Ft. from N. Line

_____ Ft. from S. Line

330 Ft. from E. Line

_____ Ft. from W. Line

BIG CREEK POOL

Location _____

Rig up _____

Drilling and Remarks:

*Topeka 2780**5" @ 2780**4000 cu. ft.**F.P. 2179 P.S.**36 1/2 ft.*

RECORD

Cased _____ in., _____ ft.

Sand _____

Gas _____

Oil _____

Total Depth 2794

PRODUCTION

1st 24 hrs. Nat. _____

1st 24 hrs. after shot _____

Gas _____ Cu. Ft.

Dry Hole _____

Abandoned _____

Date

FEB 19 1941 19

S. J. LEWIS Scout

1941
2/19

Topeka 2780'

8" - 2780'

T.D. 2794'

4000 acid.

Potential 2179 bbls., pump &
flow.

36.2 Gravity

COMPLETED