


Section 16 Township 14 Range 14W

Well No. #2 Coady "B"

Company H. B. Shumaker

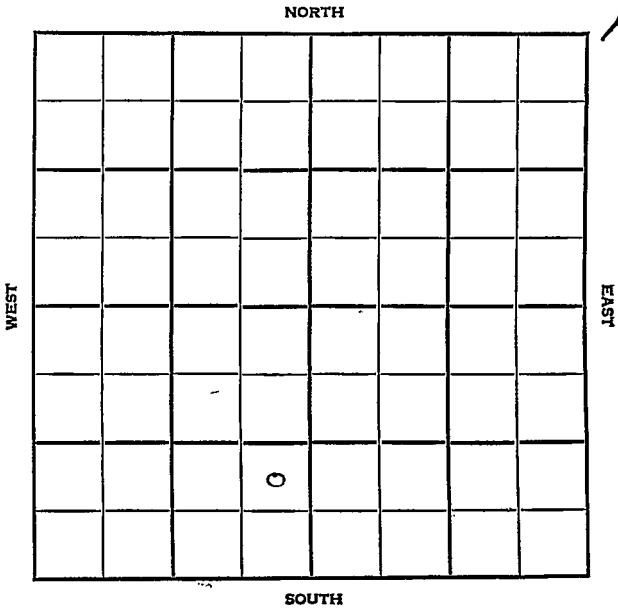

Russell KANSAS

SEC.	TWP.	R.
16	14	14W

WELL NO. **2 Coady "B"** FARM

COMPANY **H. B. Shumaker**

CONTRACTOR **Shields**


Hall-Gurney Pool

_____ Ft. from N. Line

990 _____ Ft. from S. Line

330 _____ Ft. from E. Line

33 _____ Ft. from W. Line

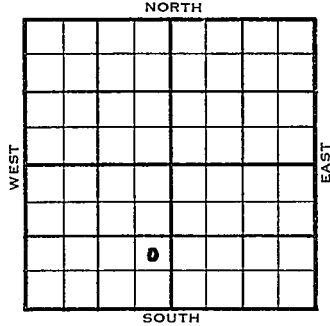

NE SE SW

1955	ELEVATION	REPORT
------	-----------	--------

4/6
 Spud 4-1-55
 8" @ 183'
 Anhy 892'
 Drlg. 2000'

