


Section 16 Township 14 Range 14W
Well No. #1 Fink
Company H. B. Shumaker

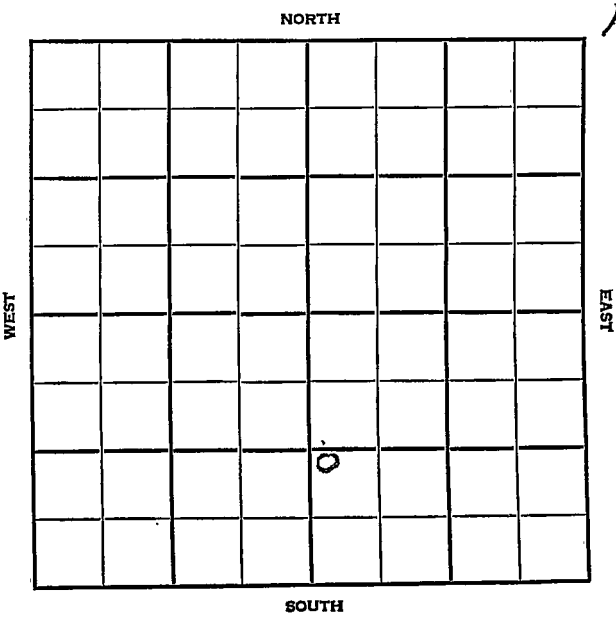

Russell

KANSAS

SEC.	TWP.	R.
16	14	14W

WELL NO.

1 Fink

FARM

COMPANY

H. B. Shumaker

CONTRACTOR

Shields

_____ Ft. from N. Line


_____ Ft. from S. Line

_____ Ft. from E. Line

_____ Ft. from W. Line

NW SW SE

CRA - FO

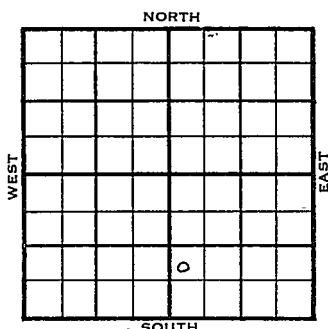

1955

ELEVATION

REPORT

5/26

R U R.

KC test

6/15

Comm 5-17-55

8 5/8", @ 175/75, DST 3042-3131 open
 1 hr. Rec. 31' socmsw 160# DST 3280
 99, open 1/2 hr. Rec 10' mud 40# 4 1/2
 @ 3287, DD 3316, VSSO PB 3235, 12/
 3222-25, 16/3200-04, 12/3183-86,
 500 A PB 3164 12/3126-29, 23/3134-40
 11/3144-47 SSO 500 M4A 4000 A S/wtr.
 scum of oil D&A.

Tops:	Depth	Datum
Anh.	880	
Severy	2747	863
TR. Top.	2750	866
Dg. Heeg	2980	1096
BL tor.	2999	1115
L.	3039	1155
Wash	3287	1403
TD.	3299	

ABANDONED

Twp. Pool

Co. Facet

FIRST REPORT

FORM 513 REV. SUNRAY

County Russell Elev. 14W
Sec. 16 Twp. (14) Rge. 14W
Company H. B. Shumaker
Farm Name Fink No. 1

TOPS	DEPTH	DATUM
Cim Anhydrite		
Ft. Riley		
Howard		
Topeka		
Heebner Sh.		
Toronto Ls.		
Brown Lime		
Lansing		
Kansas City		
B. K. C.		
Congl.		
Miss.		
Kinderhook		
Misener		
Hutton		
Sylv. Maquo		
Viola		
Simpson		
Smp.		
Gorham		
Afbuckle		
Basal Sand		
Pre. Com.		
T. D.		

Loc. in Section NW SW SE
CRA - FO
KC test
Drig. Contr. Shields
Pool

Date Comm.
Date Comp.

RUR

Co.
Lse.
No.
S.
T.
R.

County Russell Elev. 1884Sec. 16 Twp. 14 Rge. 14WCompany H. B. ShumakerFarm Name Fink No. 1

TOPS	DEPTH	LOG	DATUM	Loc. in Sec.
Anh.	880			NW SW SE
Tr.				
Ht. <u>Severy</u>	<u>2747</u>		<u>863</u>	
Tr. <u>Top</u>	<u>2750</u>		<u>866</u>	
Dg. <u>Webb</u>	<u>2980</u>		<u>1096</u>	
Bl. <u>Top</u>	<u>2999</u>		<u>1115</u>	
L.	<u>3039</u>		<u>1155</u>	
K.C.				Geol.
B.K.C.				Contr.
Ce.				Shields
C.				
M.				Pool
M.				
K.				
Mz.				
Me.				
V.				
S.				
S.				
A.				
R.				
Pe.				
G. <u>Wash</u>	<u>3287</u>		<u>1403</u>	
TD.	<u>3299</u>			

ABANDONED

Date Comm. 5-17-55 JUN 1 5 19558 5/8" @ 175/75 DST 3042-3131 open 1 hrRec. 31' socmsw 160# DST 3280-99open 1/2 hr. Rec. 10' mud 40# 4 1/2" @3287 DD 3316 VSSO PB 323512/ 3222-25 16/ 3200-04 12/ 3183-86500 A PB 3164 12/ 3126-29 23/ 3134-40 11/ 3144-47 SSO 500 M-A 4000 A

S/ wtr. scum of oil

D & A